


Section 29 Township 16 Range 1W

Well No. #2 Peterson

Company Deep Rock

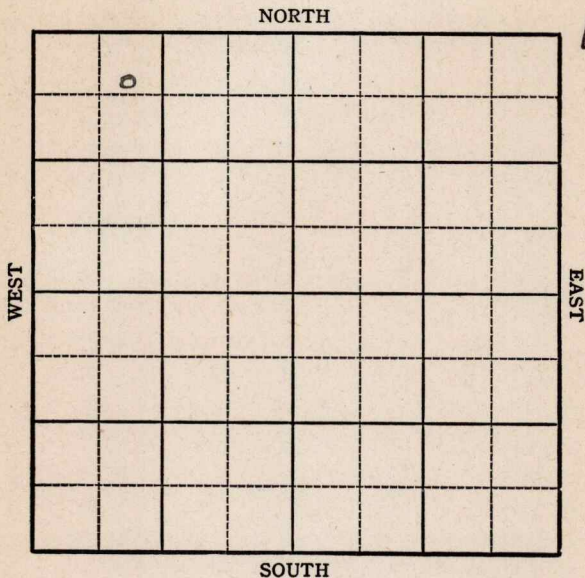

**KANSAS**

Saline

Sec. 29 Twp. 16 R. 1W

Well No. #2 Peterson Farm

Deep Rock Company


Hunter Pool

530 Ft. from N. Line

\_\_\_\_\_ Ft. from S. Line

\_\_\_\_\_ Ft. from E. Line

990 Ft. from W. Line

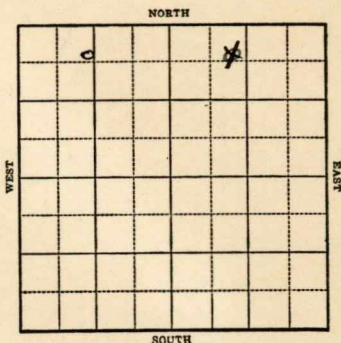

R E P O R T

1944

2/9 10" - 130  
WOC

2/15 Drlg. 25628

2/23 Miss 2622-24 TD  
7" @ 2622  
Rust

3/1 "

3/8 "

3/16 "

3/22 "

3/29 "

4/5 TD 2631-1000 acid  
Temp Pot 136 Pump

4/12 " " "

4/19 " " "

4/26 " " "

5/3 " " "

**OVER**

1944

5/10 7" @ 2622

Miss 2622

TD 2631

Pump 136 oil and 50% wtr.

Potential

Gravity 36.3

COMPLETED

Pool Name Hunter

Map No. 42 Sec. 29 Twp. 16 R. 1W

Well No. 2 Peterson

Deep Rock Company

**COMPLETED**

Contractor

C E L NW NW

**SECTION PLAT**

530 Ft. from N. Line

\_\_\_\_\_ Ft. from S. Line

\_\_\_\_\_ Ft. from E. Line

990 Ft. from W. Line

o			

Saline County

Location \_\_\_\_\_

Rig up \_\_\_\_\_

Drilling and Remarks:

*Miss 2622  
7" C 2622*

*Pump 136 oil + 50% Water  
P.O.*

*36 1/2 in*

**RECORD**

Cased \_\_\_\_\_ in., \_\_\_\_\_ ft.

Sand \_\_\_\_\_

Gas \_\_\_\_\_

Oil \_\_\_\_\_

Total Depth 2631

**PRODUCTION**

1st 24 hrs. Nat. \_\_\_\_\_

1st 24 hrs. after shot \_\_\_\_\_

Gas \_\_\_\_\_ Cu. Ft.

Dry Hole \_\_\_\_\_

Abandoned \_\_\_\_\_

Date

MAY 10 1944 19

S. J. LEWIS Scout

KANSAS

Map No. 42 Sec. 29 Twp. 16 R. 1W

Well No. 2 Peterson

Deep Rock Company

FIRST REPORT

Contractor

C E L NW NW

SECTION PLAT

530 Ft. from N. Line

\_\_\_\_\_ Ft. from S. Line

\_\_\_\_\_ Ft. from E. Line

990 Ft. from W. Line

o			

Hunter Pool

Location \_\_\_\_\_

Rig up \_\_\_\_\_

Drilling and Remarks:

10" - 130 WOC

RECORD

Cased \_\_\_\_\_ in., \_\_\_\_\_ ft.

Sand \_\_\_\_\_

Gas \_\_\_\_\_

Oil \_\_\_\_\_

Total Depth \_\_\_\_\_

PRODUCTION

1st 24 hrs. Nat. \_\_\_\_\_

1st 24 hrs. after shot \_\_\_\_\_

Gas \_\_\_\_\_ Cu. Ft.

Dry Hole \_\_\_\_\_

Abandoned \_\_\_\_\_

Date

FEB 9 1944 19

S. J. LEWIS Scout