


Section 33 Township 14 Range 13 W

Well No. # 3 Hefferman

Company Gene O. Huebner et al (Was Russell Drl)

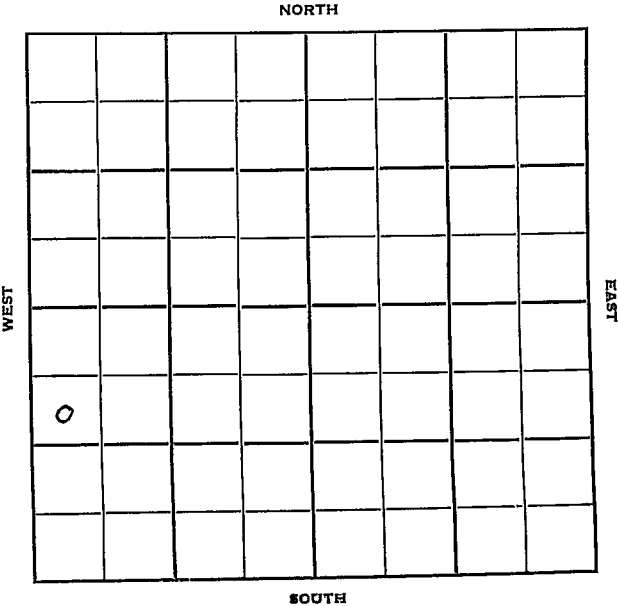

Russell

KANSAS

Sec. 33 Twp. 14 R. 13W

Well No. #3 Hefferman Farm

Gene O. Huebner et al (Was Russell Company
Drig.

Shields

Contractor

Hall-Gurney Pool


990 Ft. from N. Line

 Ft. from S. Line

 Ft. from E. Line

330 Ft. from W. Line

SW NW SW

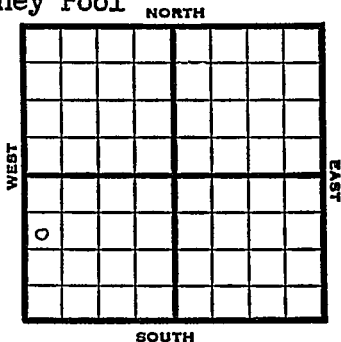

1951

Elev. 1701'

REPORT

10/3

Location

11/7

Spud 10-5-51

Oil Well TD 2250

12" @ 320'

Anhy 645

10" @ 647' 8" @ 2040

Tarkio 2229'

5" @ 2230 TD 2250

PB 2240 Hydrafrac

Comp. 50 BOPD

COMPLETED

County Russell State Kansas
 Sec. 33 (Blk. 14) (Sur. 13W) Map No. 13W
 Operator Gene O. Huebner et al. (was Russell Drlg.)
 Well No. 3 Farm Hefferman
 Elev. _____ Location SW NW SW

FIRST REPORT

990 Ft. From N Line SW

330 Ft. From W Line Quarter

1st. Report OCT 3 1951

Completion

Remarks

Shields - Contr.


Spudding Date

Drlg. Data Hall-Gurney Pool

Location

J. E. TYRA

County Russell State Kansas
 Sec. 33 (Blk. 14) (Sur. 13W) Map No.
 Operator Gene O. Huebner et al. (was Russell Drig.)
 Well No. 3 Farm Hefferman
 Elev. 1701 Location SW NW SW

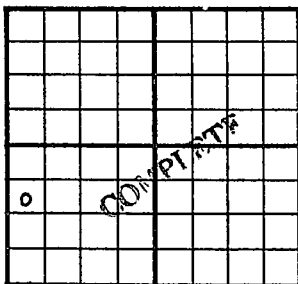

990 Ft. From N Line SW
330 Ft. From W Line Quarter
 Ist. Report
 Completion NOV 7 1951
 Remarks Hall-Gurney Pool
Shields - Contr.
 Spudding Date 10-5-51

Drig. Data Oil well TD 2250
12" @ 320 Anhy 645 10" @ 647 8" @ 2040
Tarkio 2229 5" @ 2230 TD 2250 PB 2240
Hydrofrac Comp. 50 bopd

J. E. TYRA