


Section 33 Township 14 Range 13 W

Well No. # 2 Hefferman

Company Advance Drlg.

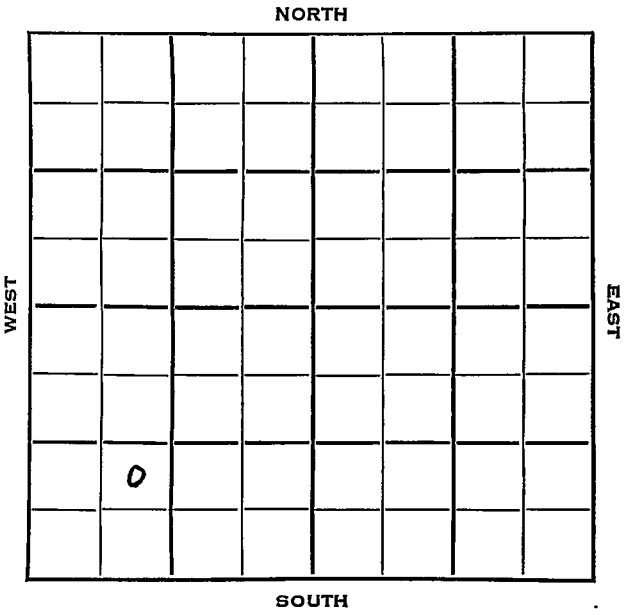

Sec. 33 Twp. 14 R. 13W

Well No. #2 Hefferman Farm

Advance Drlg. Company

Advance Drlg. Contractor


_____ Ft. from N. Line

990 Ft. from S. Line

_____ Ft. from E. Line

990 Ft. from W. Line

NE SW SW

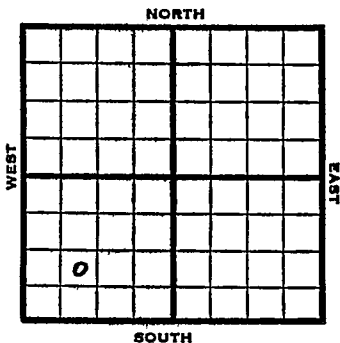

1953 Elev. -

REPORT

5/13 Spud 4-19-53
 10" @ 335
 Tarkio 2256
 5" @ 2257
 TD 2265
 Sd-frac
 S/12-14 boph
 POP

5/20 Spud 4-19-53
 Oil Well
 TD 2265
 10" @ 335
 Tarkio 2256
 5" @ 2257
 TD 2265
 sd-frac
 S/12-14 boph
 Comp. 50 bopd

COMPLETED

