


SECTION 35 TOWNSHIP 13 RANGE 17W

WELL NO. #1 Kuhn "D"

COMPANY Birmingham & Bartlett

NORTH

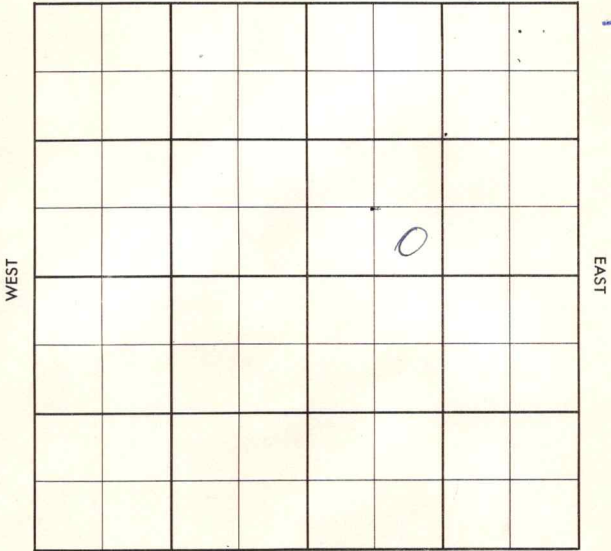

SOUTH

County Ellis Elev. \_\_\_\_\_  
 Sec. 35 Twp. 13 Rge. 17W  
 Company Birmingham & Bartlett  
 FarmName Kuhn "D" No. 1

TOPS	DEPTH	LOG	DATUM
Anh.			
TP.			
H.			
Tr.			
Dg.			
Bl.			
L.			
K.C.			
B.K.C.			
Ce.			
C.			
M.			
M.			
K.			
Mz.			
Mo.			
V.			
S.			
S.			
A.			
R.			
PE.			
G.			
T.D.			

Loc. in Sec. \_\_\_\_\_

SE SW NE

Geol. \_\_\_\_\_

Contr. \_\_\_\_\_

Pool \_\_\_\_\_

Toulon

SEP 26 '56

FIRST REPORT

0

SDX - (OFFSET)

Date Comm. \_\_\_\_\_

Location \_\_\_\_\_

OCT 1 1956

R.G.

Co.

Lse.

No.

Sec.

T.

R.

County Ellis Elev. 1968  
 Sec. 35 Temp. 13 Rgs. 17W  
Birmingham & Bartlett  
Kuhn "D" No. 1

TOPS	DEPTH	LOG	DATUM	Loc. in Sec.
Anh.	1144			SE SW NE
Tp.				
H.	3205			Geol.
Tr.	3226			
Dg.				Contr.
Bl.				
L.	3252			Pool
K.C.				
B.K.C.				Toulon
Ce.				
C.	3494			ABANDONED
M.				
M.				(OFFSEET)
K.				
Mz.				OCT 24 '56
Mo.				
V.				
S.				
A.	3506			
R.				
PE.				
G.				
T.D.	3517			

Date Comm. OCT 3 '56 OCT 10 '56 CCD OCT 17 '56  
 Location

10-13-56 8 3/8 188 1165  
1714 OCT 24 '56 DST 3240-3304  
1hr 255' MSW BHP 825 DST  
3508-12 hr 40" net 15' Md  
BHP 0 DST 3493-3517 30" net  
25' Md BHP 0

D&W