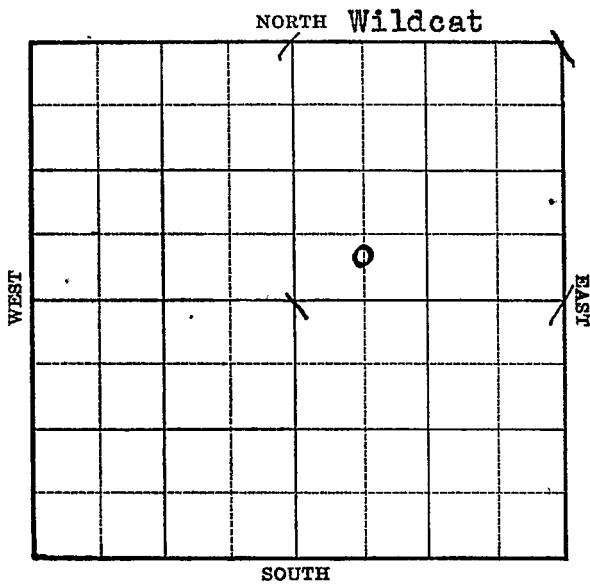


Section 33 Township 14 Range 13-WWell No. 1 CarterCompany Skelly

1939	REPORT
2/15	Cellar
2/23	B.R.R.
3/3	T.D. 312' Rng. 13".
3/10	13" - 257' Drlg. 1727'
3/16	Top Lansing 2824
	Stain oil 2847-52 & 2861-62 TD 2862
	Running 6" to bottom Will perforate
3/16	T.D. 2862 6" 2862 WOC (Tel)
3/22	T.D. 2870 Bailed 1/2 bbl. oil in 4 hours No water Bldg. tanks Will acidize (Tel)
3/31	5000 acid. Swab 44 bbls. oil in 3 hours. Perf. 60 shots 2845- 2850' Inc. oil & gas. 4000 acid.
4/7	Swab 148 oil in 10 hrs. Pump 44 oil in 1 hour. SD tanks.
	OVER

Map No. 72 Sec. 33 Twp. 14 R. 13WWell No. 1 CarterSkelly Company


Contractor

FIRST REPORT

C S L SW NE

 Ft. from N. Line460 Ft. from S. Line Ft. from E. Line660 Ft. from W. Line

SECTION PLAT

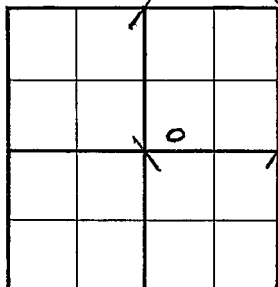

WILDCAT

Location Rig up

Drilling and Remarks:

Cellar

RECORD

Cased in., ft.Sand Gas Oil Total Depth

PRODUCTION

1st 24 hrs. Nat. 1st 24 hrs. after shot Gas Cu. Ft.Dry Hole Abandoned

Date

FEB 15 1939 19 H. D. Hatfield Scout

Map No. 72 Sec. 33 Twp. 14 R. 13WWell No. 1 CarterSkelly

Company

Contractor

COMPLETED

C S L SW NE

Ft. from N. Line

460 Ft. from S. Line

Ft. from E. Line

660 Ft. from W. Line

SECTION PLAT

		0	

WILDCAT

Location

Rig up

Drilling and Remarks:

9000 Acid Total

Perforations 2845-50

P- 17 1/8

Pot 524

RECORD

Cased 6 in., 2862 ft.Sand LENS 2824

Gas

Oil

Total Depth 2870

PRODUCTION

1st 24 hrs. Nat.

1st 24 hrs. after shot

Gas Cu. Ft.

Dry Hole

Abandoned

Date

APR 12 1939

19

H. D. Hatfield Scout

1939

4/12

6" - 2862'

Lans. 2824'

T. D. 2870'

9000 acid total.

Perforations 2845-50'

Pump 174 bbls. 8 hrs.

Potential 524 bbls.

COMPLETED