

KANSAS


Ellis

FORM 51 5M PETROL

Section 35 Township 13 Range 17W

Well No. 1 Sander

Company Tom Allan etal

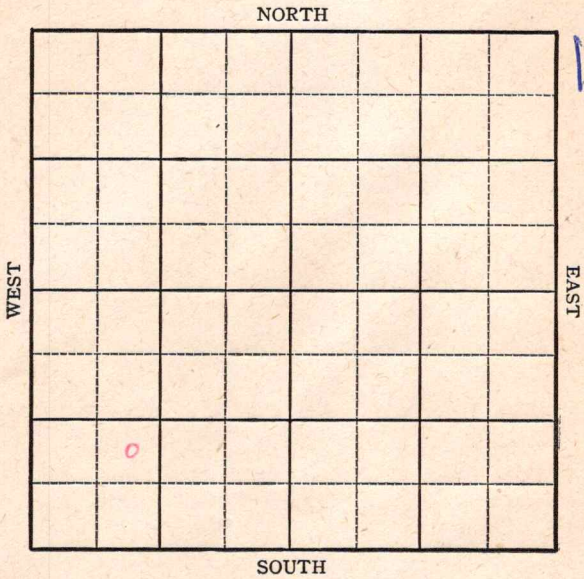

KANSAS Ellis

Sec. 35 Twp. 13 R. 17-W


Well No. #1 Sander Farm
Tom Allan et al Company

 Ft. from N. Line

990 Ft. from S. Line

 Ft. from E. Line

990 Ft. from W. Line

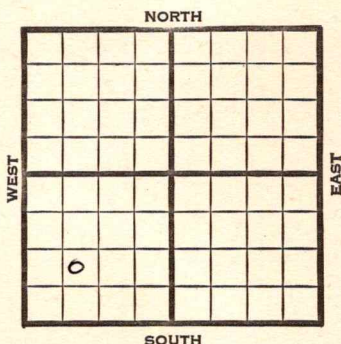

NE SW SW

1945

REPORT

Elev. 1958

8/8

13" @ 50'

Anhy. 1147

8" @ 1150'

2390'

8/15

Cong 3514

TD 3560'

ABANDONED

Kansas Pool Name CatherineMap No. 71 Sec. 35 Twp. 13 R. 17WWell No. 1 SanderTom Allan et al Company**ABANDONED**NE SW SW Contractor12/1/95
SECTION PLAT

0			

Ft. from N. Line990 Ft. from S. LineFt. from E. Line990 Ft. from W. LineEllis County

Location _____

Rig up _____

Drilling and Remarks:

Conc 3514**RECORD**

Cased _____ in., _____ ft.

Sand _____

Gas _____

Oil _____

Total Depth 3560**PRODUCTION**

1st 24 hrs. Nat. _____

1st 24 hrs. after shot _____

Gas _____ Cu. Ft.

Dry Hole _____

Abandoned _____

Date

AUG 15 194519S. J. LEWISScout

KANSAS

Pool Name CatherineMap No. 71 Sec. 35 Twp. 13 R. 17WWell No. 1 SanderTom Allan etal


Company

FIRST REPORT

Contractor

NE SW SW

SECTION PLAT

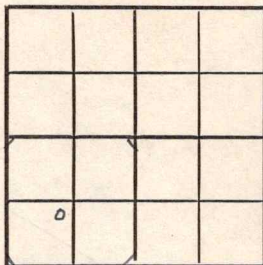 Ft. from N. Line990 Ft. from S. Line Ft. from E. Line990 Ft. from W. Line

Ellis County

Location Rig up

Drilling and Remarks:

13"-50Anhy 11478"-11502390

RECORD

Cased in., ft.Sand Gas Oil Total Depth

PRODUCTION

1st 24 hrs. Nat. 1st 24 hrs. after shot Gas Cu. Ft.Dry Hole Abandoned

Date

AUG 8 194519S. J. LEWIS

Scout