

# KANSAS

FORM 51 5M 4-41 PETROL


Russell

Section 25 Township 14 Range 13-W

Well No. #1 Goodhart

Company Texas

Hall Gurney Pool

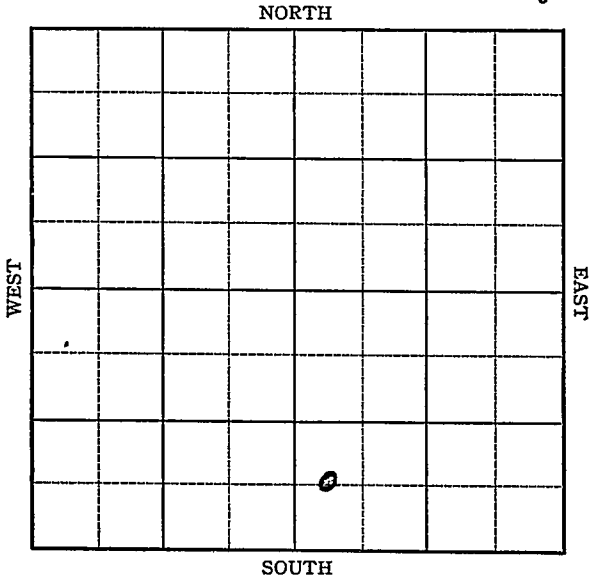



Map No. 72 Sec. 25 Twp. 14 R. 13WWell No. 1 GoodhartTexas

Company

FIRST REPORT


Contractor

C W L SW SE

         Ft. from N. Line660 Ft. from S. Line         Ft. from E. Line330 Ft. from W. Line

HALL GURNEY POOL

## SECTION PLAT

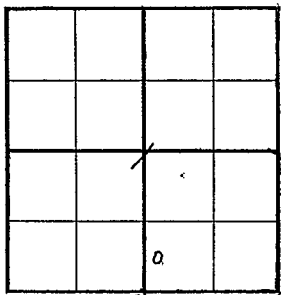Location XRig up         

Drilling and Remarks:

## RECORD

Cased          in.,          ft.Sand         Gas         Oil         Total Depth         

## PRODUCTION

1st 24 hrs. Nat.         1st 24 hrs. after shot         Gas          Cu. Ft.Dry Hole         Abandoned         

Date

MAY 7 1941 19S. J. LEWIS

Scout

Map No. \_\_\_\_\_ Sec. 25 Twp. 14 R. 13WWell No. 1 Goodhart

\_\_\_\_\_ Texas \_\_\_\_\_ Company

\_\_\_\_\_ **COMPLETED** \_\_\_\_\_ Contractor**C W L SW SE**

\_\_\_\_\_ Ft. from N. Line

660 Ft. from S. Line

\_\_\_\_\_ Ft. from E. Line

330 Ft. from W. Line**HALL GURNEY POOL****SECTION PLAT**

		o	

Location \_\_\_\_\_

Rig up \_\_\_\_\_

Drilling and Remarks:

*Ac 83113**7" @ 3111**Dept. 18 P. 2133**7 1/2 % Water**38° SW***RECORD**

Cased \_\_\_\_\_ in., \_\_\_\_\_ ft.

Sand \_\_\_\_\_

Gas \_\_\_\_\_

Oil \_\_\_\_\_

Total Depth 3118 1/2**PRODUCTION**

1st 24 hrs.-Nat. \_\_\_\_\_

1st 24 hrs. after shot \_\_\_\_\_

Gas \_\_\_\_\_ Cu. Ft.

Dry Hole \_\_\_\_\_

Abandoned \_\_\_\_\_

Date

JUN 4 1941 19 \_\_\_\_\_ S. J. LEWIS Scout