


Section 25 Township 14 Range 13W

Well No. 13 Goodhart

Company Texas Company

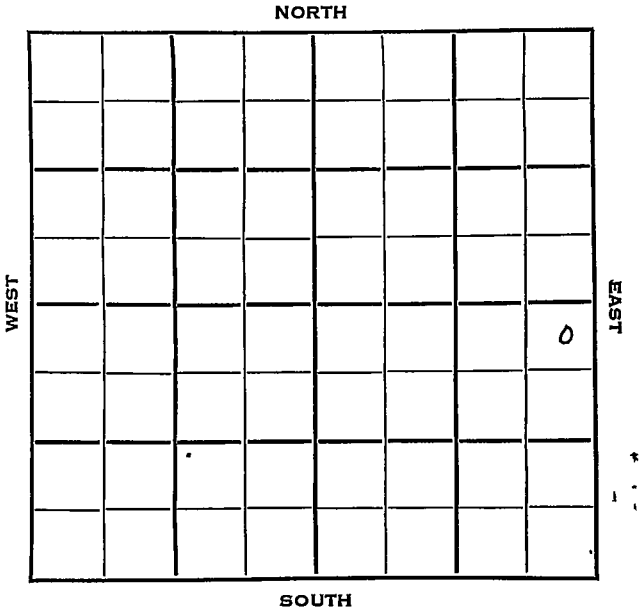

Sec. 25 Twp. 14 R. 13 W

Well No. # 13 Goodhart Farm

Texas Company Company

Wakefield Contractor


340 Ft. from N. Line

_____ Ft. from S. Line

340 Ft. from E. Line

_____ Ft. from W. Line

NE NE SE (Twin well)

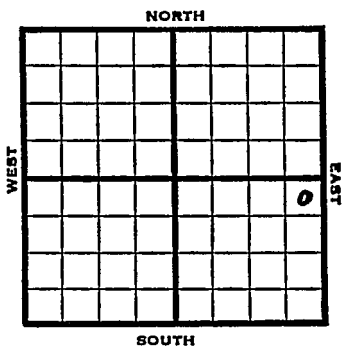

1952 Elev. 1707 REPORT

12/17 MICT
 12/25 MICT
 1/1 Drl g. 105
 1/8 NR
 1/22 Tarkio 2200' TD 2225' 7" @ 2224'
 1/29 DD 2343 TD dry
 12/2199-2202, 8½ GWPH sq.
 2/5 Testing
 2/12 NR
 2/18 Spudding Date 12/28/52
 Oil Well TD 2343
 10" @ 657 Tarkio 2200 TD 2225
 7" @ 2224 DD 2343 dry 12/2199-
 2202 8½ gwph CO to 2215 20/2202-07
 st-frac S/11 go 14 gwph sd-frac
 S/2¼ boph Comp. 8 bopd

COMPLETED

