

Section 1 Township 13 Range 18W

Well No. #2 Grissman (*Chrissman*)

Company Alpine Oil & Royalty

NORTH

WEST

EAST

	0						

SOUTH

5

Sec. 1 Twp. 13 R. 18W

Well No. #2 Grissman Farm

Alpine Oil & Royalty Company

Quaker Contractor


..... Ft. from N. Line

990 Ft. from S. Line

..... Ft. from E. Line

990 Ft. from W. Line

NE SW NW

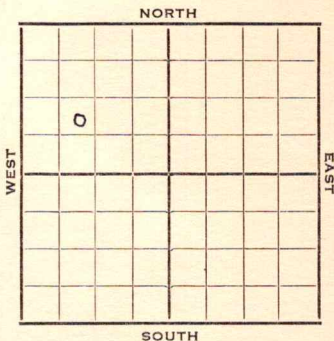

1952

Elev. 2056' REPORT

6/25

MI

7/2

8" @ 230 Anhy 1298 Heeb 3284
Drlg. 3363

7/9

Lans 3336 Cong 3564

Simp 3580 Arb. 3588

RTD 3593 5" @ 3590

DST 3349-3410 3/4 hr.

30' oil 730#

7/17

DD 3596 SO DD 3598

7/23

500 A 4 Boph POP

7/30

Spud 6-23-52

Oil well TD 3598' 8" @ 230

Anhy 1298' Heeb 3284' Lans. 3336'

Cong. 3564' Simp. 3580' Arb. 3588'

TD 3593' 5" @ 3590

DST 3349-3410' open 3/4 hr. rec 30'

oil speck mud 730# DD 3596

DD 3598' 500 A 4 BOPH

Comp. 90 BOPD

COMPLETED

County **Ellis** State **Kansas**

Sec. **1** (Blk. **13** (Sur. **18W** Map No. (Twp. **13** (Rge. **18W**)

Operator **Alpine Oil & Royalty**

Well No. **2** Farm **Crissman**

Elev. Location **NE SW NW**

990 Ft. From **S** Line **NW**

990 Ft. From **W** Line Quarter

Ist. Report **JUN 25 1952**

Completion

Remarks

Quaker - Contr.

Spudding Date

Drlg. Data

MI

J. G. McGEHEE

