

KANSAS

Russell


FORM 51 5M 1-42 PETROL

Section 25 Township 14 Range 13-W

Well No. #3 Goodheart

Company Texas

NORTH Hall Gurney Pool

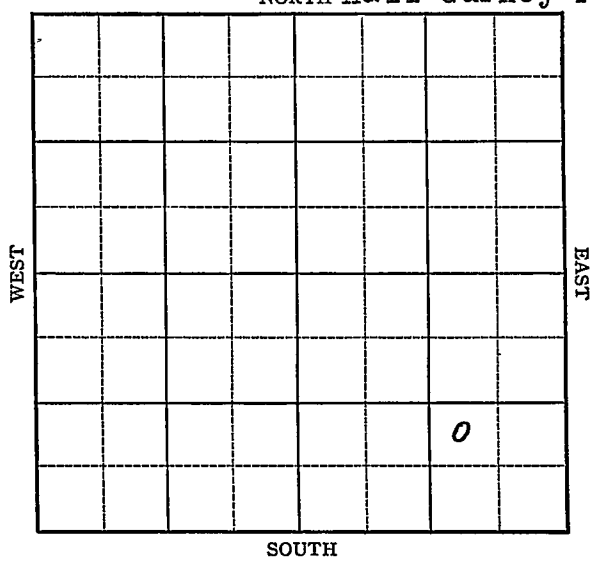

Russell **KANSAS**Map No. 72 Sec. 25 Twp. 14 R. 13WWell No. 3 GoodheartTexas

Company

FIRST REPORT

Contractor

NW SE SE

SECTION PLAT

			o

 Ft. from N. Line990 Ft. from S. Line990 Ft. from E. Line Ft. from W. Line

HALL GURNEY POOL

Location XXRig up

Drilling and Remarks:

RECORD

Cased in., ft.Sand Gas Oil Total Depth

PRODUCTION

1st 24 hrs. Nat. 1st 24 hrs. after shot Gas Cu. Ft.Dry Hole Abandoned

Date

FEB 25 1942 19S. J. LEWIS Scout

Rus sell

Map No. 72 Sec. 25 Twp. 14 R. 13W

Well No. 3 Goodheart

Texas Company

COMPLETED

Contractor

NW SE SE

SECTION PLAT

			o

_____ Ft. from N. Line

990 Ft. from S. Line

990 Ft. from E. Line

_____ Ft. from W. Line

HALL GURNEY POOL

Location _____

Rig up _____

Drilling and Remarks:

Ca 83108
7" C 3110
Depth 81207

28° N

RECORD

Cased _____ in., _____ ft.

Sand _____

Gas _____

Oil _____

Total Depth 9113

PRODUCTION

1st 24 hrs. Nat. _____

1st 24 hrs. after shot _____

Gas _____ Cu. Ft.

Dry Hole _____

Abandoned _____

Date

MAR 25 1942 19

S. J. LEWIS Scout