

KANSAS


Russell

FORM 51 IOM 12-46 PETROL

Section 25 Township 14 Range 13W

Well No. 2 Goodheart

Company V, D . Sidey

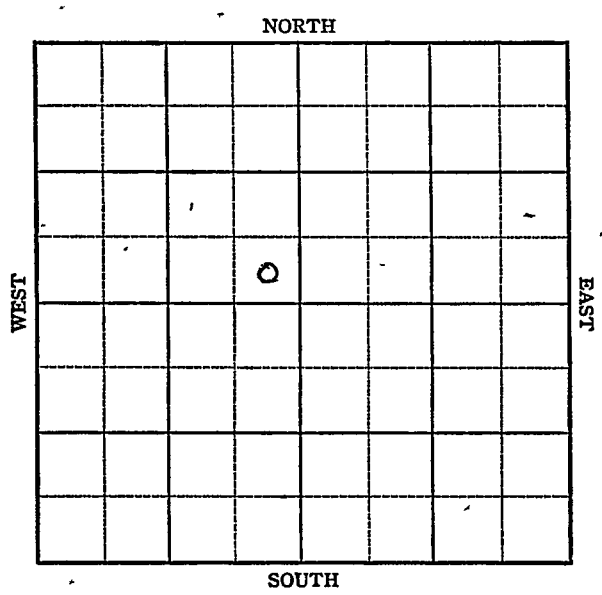

LANSING

Russell ✓

Sec. 25 Twp. 14 R. 13-W

Well No. #2 Goodheart Farm


V. D. Sidey Company

 Ft. from N. Line

330 Ft. from S. Line

330 Ft. from E. Line

 Ft. from W. Line

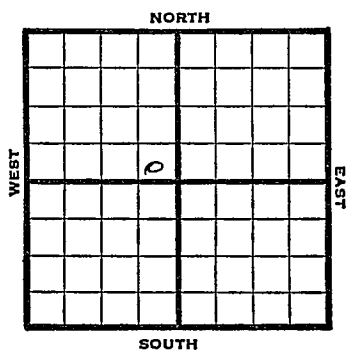

SE NW

1947 Elev. 1725' REPORT

5/14	15" @ 94'	12" @ 350'	Drlg 500'
5/20	Anhy 652	10" @ 654'	Drlg 1500'
5/27	Drlg. 2200'		
6/3	2510 HR 8"		
6/10	Drlg. 2600'		
6/17	Drlg 2960'		
6/24	7" @ 2596'		
7/1	Will not give out information have se pipe.		
7/8	"	"	"
7-16	"	"	"
7/23	Lansing 3881'		
	7" @ 2885'		
	Pump 342 Pot.		
	Gr. 40.9		
	T.D. 2975'		
	Complete		

COMPLETED

Map No. K72 Sec. 25 Twp. 14 R. 13W

Well No. 2 Goodheart

V. D. Sidey Company

FIRST REPORT Contractor

SE NW

SECTION PLAT

_____ Ft. from N. Line

330 Ft. from S. Line

330 Ft. from E. Line

_____ Ft. from W. Line

Russell County

Location _____

Rig up _____

Drilling and Remarks:

15" @ 94'

12" @ 350'

550'

RECORD

Cased _____ in., _____ ft.

Sand _____

Gas _____

Oil _____

Total Depth _____

PRODUCTION

1st 24 hrs. Nat. _____

1st 24 hrs. after shot _____

Gas _____ Cu. Ft.

Dry Hole _____

Abandoned _____

Date

MAY 14 1947

19

S. J. LEWIS

Scout

