

KANSAS

Form 51-5M-7-40-Palace

Ellis


Section 1 Township 13 Range 18-W

Well No. #3 Keys

Company Bay Petroleum

Walters Pool

NORTH

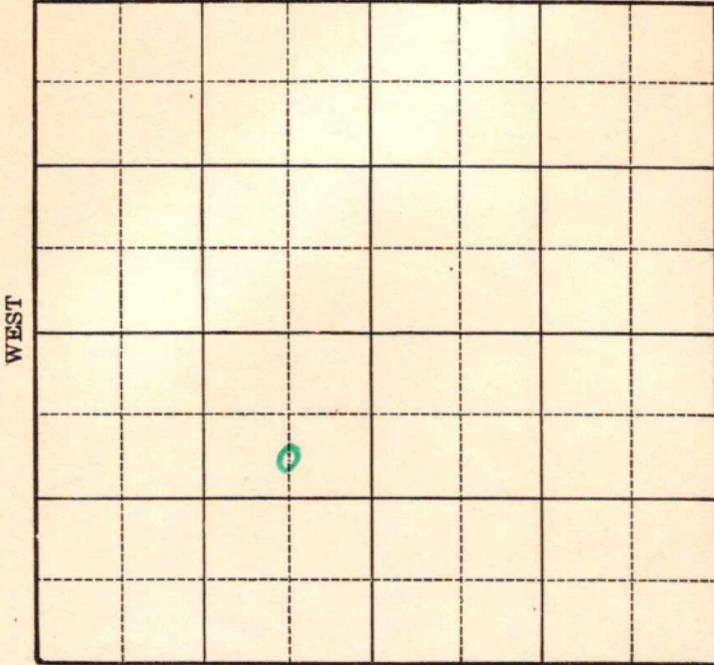

SOUTH





Map No. 71 Sec. 1 Twp. 13 R. 18W

Well No. 3 Keys

Bay Petroleum Company

Contractor

**ABANDONED**

C S L NE SW

990 Ft. from N. Line

\_\_\_\_\_ Ft. from S. Line

660 Ft. from E. Line

\_\_\_\_\_ Ft. from W. Line

WALTERS POOL

**SECTION PLAT**


Location \_\_\_\_\_

Rig up \_\_\_\_\_

Drilling and Remarks:

*Liana 3410*  
*BTC 3675*  
*Comp. 3772*

**RECORD**

Cased \_\_\_\_\_ in., \_\_\_\_\_ ft.

Sand \_\_\_\_\_

Gas \_\_\_\_\_

Oil \_\_\_\_\_

Total Depth 3772

**PRODUCTION**

1st 24 hrs. Nat. \_\_\_\_\_

1st 24 hrs. after shot \_\_\_\_\_

Gas \_\_\_\_\_ Cu. Ft.

Dry Hole \_\_\_\_\_

Abandoned \_\_\_\_\_

Date

JAN 22 1941

S. J. LEWIS Scout