

Section 1 Township 13 Range 18W

Well No. #1 Staab

Company Jones, Shelburne & Farmer

NORTH

WEST

EAST

				0			

SOUTH

2

Sec. 1 Twp. 13 R. 18W

Well No. #1 Staab Farm

Jones, Shelburne & Farmer Company

Jones, Shelburne & Farmer Contractor


990' Ft. from N. Line

_____ Ft. from S. Line

_____ Ft. from E. Line

330' Ft. from W. Line

SW NW NE

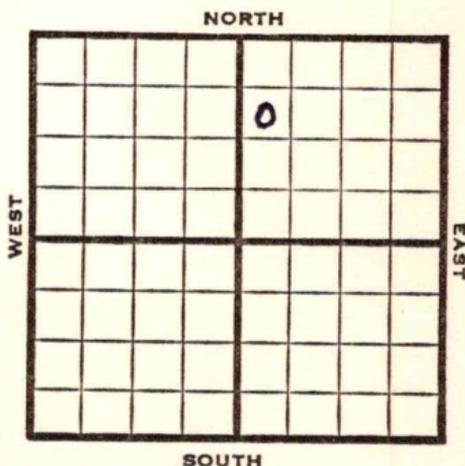

1952 **Elev. 2051'** REPORT

7/2 Spud 6-29-52
8" @ 166

7/9 **Anhy 1310** Drlg. 3324

7/17 **Heeb. 3278 Tor. 3306 KC 3330**
DST 3339-3404 1/2 hr. 15' M 680#
DST 3404-21 6' M 940# TD 3660
D&A Hold

7/23 Spud 6-29-52 D&A TD 3660
8" @ 166 **Anhy 1310 Heeb. 3278**
Tor. 3306 KC 3330
DST 3339-3404 opn 1/2 hr. Rec. 15' mud
680#
DST 3404-3421 Rec. 6' mud 940#
Cong. 3571 TD 3660
D&A


County **Ellis** State **Kansas**

Sec. **1** (Blk. Twp.) **13** (Sur. Rge.) **18W** Map No.

Operator **Jones, Shelburne & Farmer**

Well No. **1** Farm **Staab**

Elev. _____ Location **SW NW NE**

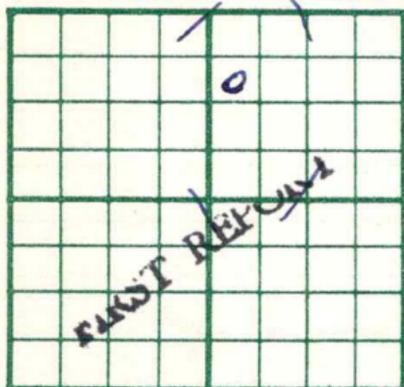

990 Ft. From **N** Line **NE**

330 Ft. From **W** Line Quarter

Ist. Report **JUL 2 1952**

Completion _____

Remarks _____

Jones, Shelburne & Farmer

Spudding Date **6-29-52** Contr

Drig. Data

8" @ 166

J. G. McGEHEE


County Ellis State Kans

Sec. 1 (Blk. 13 (Sur. 18W Map No. 13) (Twp. 13 (Rge. 18W))

Operator Jones, Shelburne & Farmer

Well No. 1 Farm Staab

Elev. 2051 Location SW NW NE

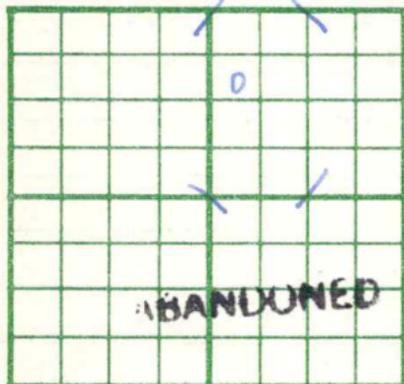

990 Ft. From N Line NE
330 Ft. From W Line Quarter

1st. Report

Completion JUL 23 1952

Remarks

J-S-F - Contr.

Spudding Date 6-29-52

Drlg. Data D & A TD 3660

8" @ 166 Anhy 1310 Heeb. 3278

Tor. 3306 KC 3330 DST 3339-3404

open 1/2 hr. Rec. 15' mud 680#

DST 3404-3421 Rec. 6' mud 940#

Cong. 3571 TD 3660

D & A