


Ellis KANSAS

DX 78-1

Section 2 Township 13 Range 18W

Well No. 1 Rankin

Company Doley Oil

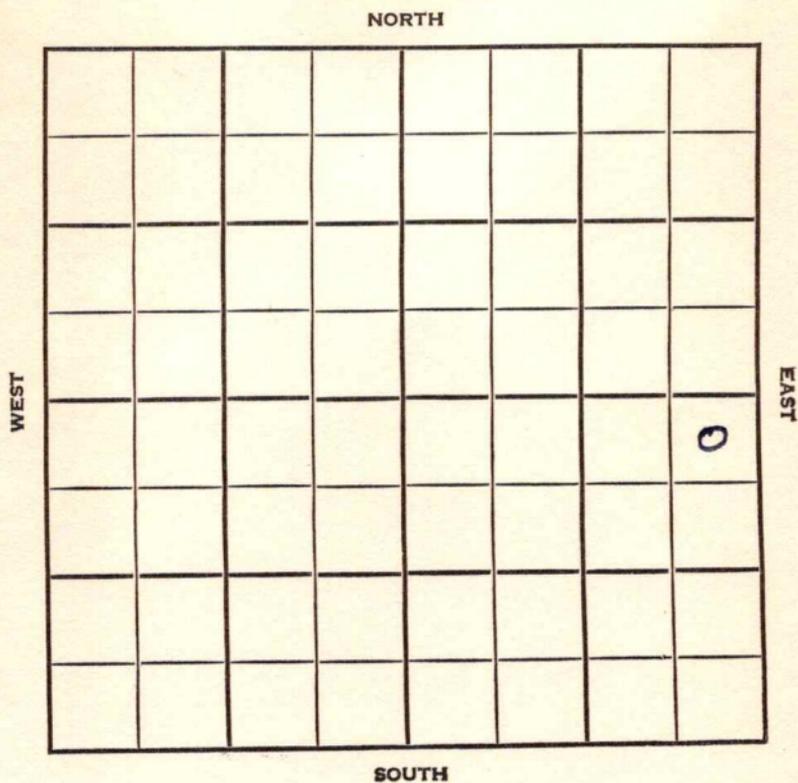


Ellis KANSAS

SEC.	2	TWP.	13	R.	18W
WELL NO.	1 Rankin				FARM

COMPANY
Doley Oil

CONTRACTOR
Keifer & Krause
N. Ubert Pool

330 _____ Ft. from N. Line
 _____ Ft. from S. Line
 330 _____ Ft. from E. Line
 _____ Ft. from W. Line

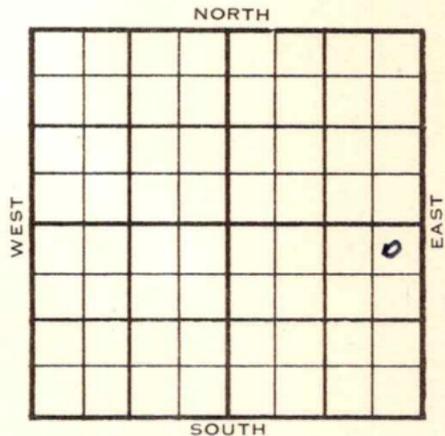

NE NE SE

1954	ELEVATION 2155'	REPORT
------	--------------------	--------

6/30
7/7

R U R
NR

7/14

Spud 6-29-54 D & A TD 3723
 8" @ 160 Heeb 3391 Lans 3437
 DST 3440-3530 open 1 hr rec 15' mud
 1120# B. Cong. 3672 Simp. 3694
 Arb. 3704
 DST 3706-13 open 1 hr rec 10' mud
 TD 3723 D & A

ABANDONED

County Ellis State Kansas

Sec. 2 (Blk.) 13 (Sur.) 18W Map No.

Operator Doley Oil

Well No. 1 Farm Rankin

Elev. _____ Location NE NE SE

330 Ft. From N Line SE

330 Ft. From E Line Quarter

1st. Report JUN 30 1954

Completion _____

Remarks _____

Keifer & Krause - Contr.

Spudding Date _____

Drlg. Data N. Ubert Pool

RUR

J. G. MCGHEE

