

KANSAS


DX 78-1

Ellis

Section 2 Township 13 Range 18 W

Well No. # 2 Rankin

Company Doley Oil Co.

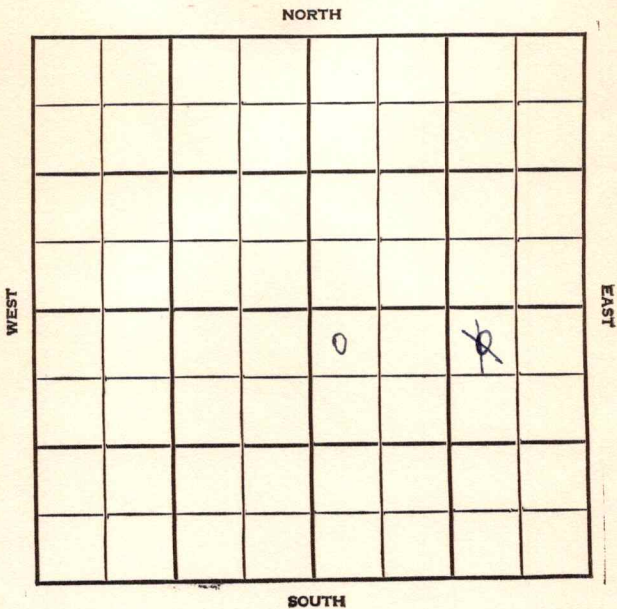

Ellis

KANSAS

SEC.	TWP.	R.
2	13	18 W

WELL NO.

2 Rankin

FARM

COMPANY

Doley Oil Co.

CONTRACTOR

K & K

Uvert Pool


330 Ft. from N. Line

Ft. from S. Line

990 Ft. from E. Line

330 Ft. from W. Line

NW ~~NE~~ SE

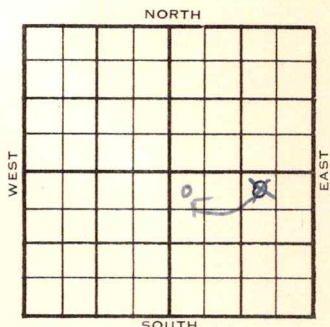

	ELEVATION	REPORT
1954	2156' DF	

9/22 Spud 9-18-54
8" @ 138 Anhy 1419
Drlg. 1528'

9/29 Spud 9-18-54
D & A
TD 3730'
8" @ 138'
Anhy 1419', Heeb 3396', Dodge 3414'
Lans 3442', B KC 3626' Cong. 3684',
Simp sh. 3698', Arb 3702',
DST 3710'-30' opn $\frac{1}{2}$ hr, rec 8' Mud
1000#
TD 3730'
D & A

ABANDONED

FABEN GILSTRAP

County Ellis State KansasSec. 2 (Blk. Twp.) 13 (Sur. Rge.) 18W Map No.Operator Doley Oil Co.Well No. 2 Farm RankinElev. 2156 DF Location NW NW SE330 Ft. From N Line SE330 Ft. From W Line Quarter1st. Report Sep 22 1954Completion SEP 29 1954Remarks Wayne Lebsack-Geol.K. K. ToolsSpudding Date 9/18/54Drlg. Data D & A TD 3730 Ubert Pool8" @ 138 Anhy 1419 Heeb. 3396Dodge 3414 Lans. 3442 B KC 3626Cong. 3684 Simp. sh. 3698 Arb. 3702DST 3710-30 open $\frac{1}{2}$ hr. Rec. 8' mud1000# TD 3730D & A

FABEN GILSTRAP

Map No. _____ Sec. 2 Twp. 13 R. 18WWell No. 2 Rankin

Doley Oil Co. _____ Company


CORRECTION_____
Contractor

NW NW SE

SECTION PLAT330 Ft. from N. Line

_____ Ft. from S. Line

_____ Ft. from E. Line

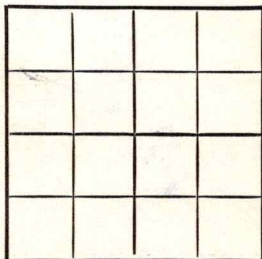330 Ft. from W. LineEllis

Location _____

Rig up _____

Drilling and Remarks:

Reported

NW NE SE

990' from E Line

RECORD

Cased _____ in., _____ ft.

Sand _____

Gas _____

Oil _____

Total Depth _____

PRODUCTION

1st 24 hrs. Nat. _____

1st 24 hrs. after shot _____

Gas _____ Cu. Ft.

Dry Hole _____

Abandoned _____

Date

SEP 29 1954

19

FABEN GILSTRAP

Scout