


Section 12 Township 13 Range 18W

Well No. #1 Dreiling

Company M & L Oil

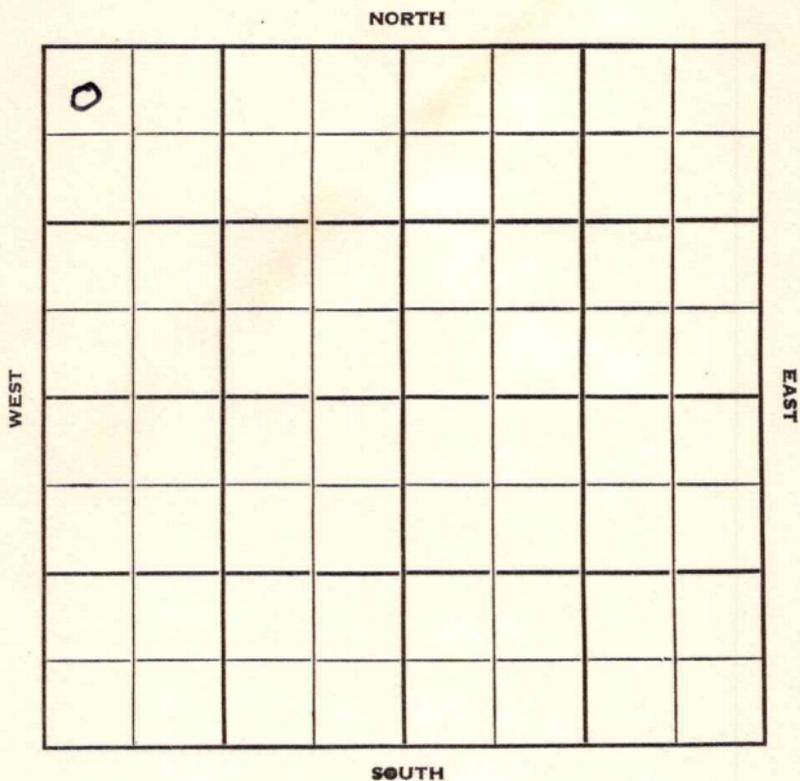

Ellis

KANSAS



Sec. 12 Twp. 13 R. 18W

Well No. #1 Dreiling Farm

M & L Oil Company

Quaker Drlg. - Contr. Contractor

Semi-Wildcat


330' Ft. from N. Line

Ft. from S. Line

Ft. from E. Line

330' Ft. from W. Line

NW NW NW

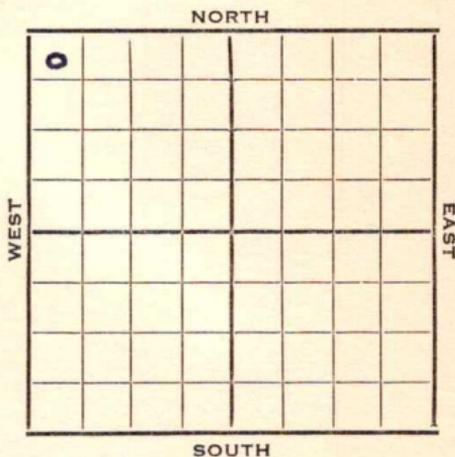

1952

Elev. 2138' REPORT

7/9

Spud 7-6-52

8" @ 230

Anhy 1397

Drlg. 2070'

7/16

Spud 7-6-52

D & A TD 3721' 8" @ 230

Anhy 1397' Heeb 3378' KC 3423'

Cong. 3653' Simp. 3683' Arb. 3701'

TD 3721' D & A

ABANDONED



