


Section 9 Township 13 Range 18W

Well No. 1 L. Dreiling

Company Brunson Drlg.

Wildcat
NORTH

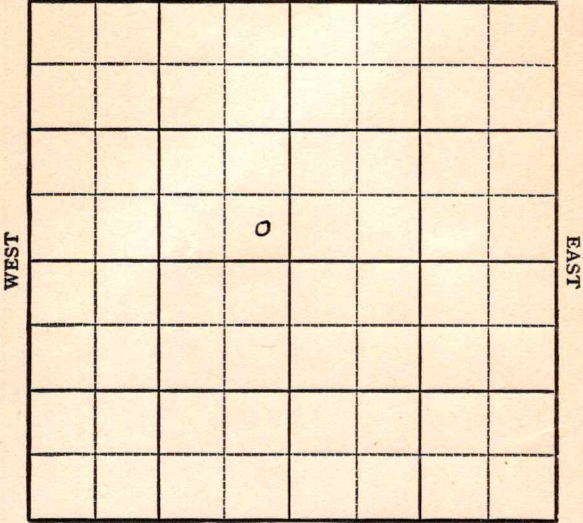

SOUTH

KANSAS

Ellis



Sec. 9 Twp. 13 R. 18W

Well No. #1 L. Dreiling Farm

Brunson Drlg. Company


Wildcat

330' Ft. from N. Line

330' Ft. from S. Line

330' Ft. from E. Line

_____ Ft. from W. Line

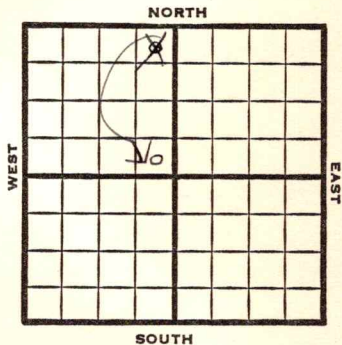

~~NE NW~~
SE HW

1948

Eli 2172'

REPORT

12/15

Surface Hole

12/22

8" @ 207'

Lansing 3485

12/29

Drlg 3625'

TD 3886'

Arb 3874'

Aband.

ABANDONED

Map No. 71 Sec. 9 Twp. 13 R. 18W

Well No. 1 L. Dreiling

Brunson Drlg. Company

CORRECTION Contractor

SE NW

SECTION PLAT

_____ Ft. from N. Line

330 Ft. from S. Line

330 Ft. from E. Line

_____ Ft. from W. Line

Ellis County

Location _____

Rig up _____

Drilling and Remarks:

Reported

NE NW

RECORD

Cased _____ in., _____ ft.

Sand _____

Gas _____

Oil _____

Total Depth _____

PRODUCTION

1st 24 hrs. Nat. _____

1st 24 hrs. after shot _____

Gas _____ Cu. Ft.

Dry Hole _____

Abandoned _____

Date

DEC 22 1948

19

S. J. LEWIS

Scout

Map No. _____ Sec. 9 Twp. 13 R. 18W

Well No. 1 L. Dreiling

Brunson Drlg. Company

FIRST REPORT Contractor

NE NW

SECTION PLAT

330 Ft. from N. Line

_____ Ft. from S. Line

330 Ft. from E. Line

_____ Ft. from W. Line

		o	

Ellis County

Location _____

Rig up _____

Drilling and Remarks:

surface hole

RECORD

Cased _____ in., _____ ft.

Sand _____

Gas _____

Oil _____

Total Depth _____

PRODUCTION

1st 24 hrs. Nat. _____

1st 24 hrs. after shot _____

Gas _____ Cu. Ft.

Dry Hole _____

Abandoned _____

Date

DEC 15 1948 19

S. J. LEWIS Scout

