

Section 15 Township 13 Range 18W

Well No. #1 Brungardt

Company H. H. Blair

NORTH

WEST

EAST

0							

SOUTH

Ellis

KANSAS 18W

Sec. 15 Twp. 13 R. 18W

Well No. #1 Brungardt Farm

H. H. Blair Company

Wildcat Contractor


Ft. from N. Line

330' Ft. from S. Line

Ft. from E. Line

330' Ft. from W. Line

SW SW SW

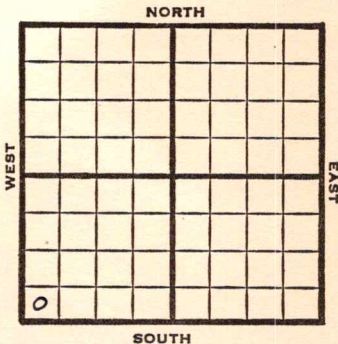

1950

REPORT

Elev 2123

6/14

Location

7/5

TD 3849
8 5/8" @ 106

Anhy 1405

Topeka 3112

Lans 3415

SO 3445-96

3501-07

3523-28

3537-41

3576-80

DST 3477-3510, 1opn 1/2 hr rec 470' SW

Heeb 3366

Dodge 3390

Lans 3415

Cong 3685

Arb 3791

TD 3849

D&A

ABANDONED

Map No. _____ Sec. 15 Twp. 13 R. 18W

Well No. 1 Brungardt

H. H. Blair Company

Contractor

SW SW SW

SECTION PLAT

_____ Ft. from N. Line

330 Ft. from S. Line

_____ Ft. from E. Line

330 Ft. from W. Line



Ellis County

Carter & Sun DHM

Location X

Rig up _____

Drilling and Remarks:

RECORD

Cased _____ in., _____ ft.

Sand _____

Gas _____

Oil _____

Total Depth _____

PRODUCTION

1st 24 hrs. Nat. _____

1st 24 hrs. after shot _____

Gas _____ Cu. Ft.

Dry Hole _____

Abandoned _____

Date

JUN 14 1950 19

J. E. TYRA Scout

Kansas

Map No. _____ Sec. 15 Twp. 13 R. 18W

Well No. 1 Brungardt

H. H. Blair Company

Contractor

SW SW SW


El. 2123
SECTION PLAT

_____ Ft. from N. Line

330 Ft. from S. Line

_____ Ft. from E. Line

330 Ft. from W. Line

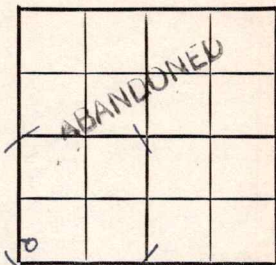

Ellis County

Location _____

Rig up _____

Drilling and Remarks:

8 5/8" @ 106

Anhy 1405

Topeka 3112

Lans. 3415

SO 3445-96

3501-07

3523-28

3537-41

Date 3576-80

RECORD

Cased _____ in., _____ ft.

Sand _____

Gas _____

Oil _____

Total Depth 3849

PRODUCTION

1st 24 hrs. Nat. _____

1st 24 hrs. after shot _____

Gas _____ Cu. Ft.

Dry Hole _____

Abandoned _____

JUL 5 1950 19

J. E. TYRA Scout