


Section 16 Township 13 Range 18W
Well No. 1 Leiker
Company Fleming & Woodman

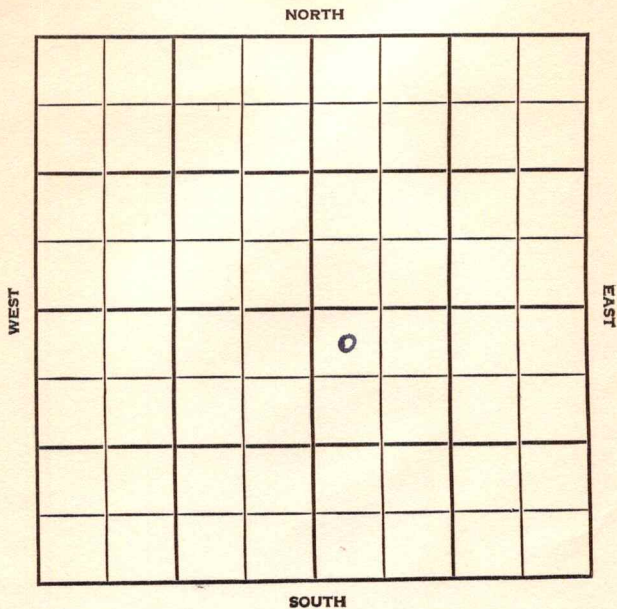

SEC.	TWP.	R.
16	13	18W

WELL NO.

#1 Leiker

FARM

COMPANY

Fleming & Woodman

CONTRACTOR

Brack

Wildcat.

330


Ft. from N. Line

Ft. from S. Line

Ft. from E. Line

330

Ft. from W. Line

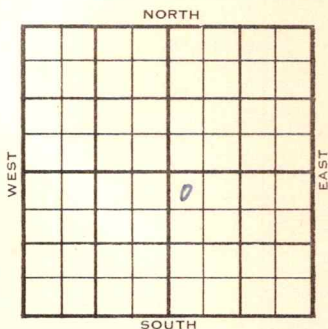

NW NW SE

Texas F/O, Lion, Carter & Pet. Inc. - DHM

	ELEVATION	REPORT
1955	XXX 2126'	
1/12	R UR	
1/26	Spud 1-11-55 - D&A TD 3785' 8" @ 258' Heeb. 3392', Tor. 3412', Lans. 3439', Arb. 3678' TD 3785' DST 3682-96', opnl hr., rec. 45' SOCM, 430# DST 3696-3718', opn 1 hr., rec. 96' WM, 900# D&A	

ABANDONED

County Ellis State KansasSec. 16 (Blk.) 13 (Sur.) 18W Map No.Operator Fleming & WoodmanWell No. 1 Farm LeikerElev. _____ Location NW NW SE

FIRST REPORT					

330 Ft. From N Line SE330 Ft. From W Line Quarter1st. Report JAN 1 2 1955

Completion _____

Remarks Texas farmout
Carter, Lion & Pet.
Inc. - DHM
Brack - Contr.

Spudding Date _____

Drlg. Data WildeatRUR

FABEN GILSTRAP

County Ellis State Kansas
 Sec. 16 (Blk.) 13 (Sur.) 18W Map No. _____
 Operator Fleming & Woodman
 Well No. 1 Farm Leiker
 Elev. 2126 Location NW NW SE



330 Ft. From N Line SE
330 Ft. From W Line Quarter

1st. Report

Completion JAN 26 1955

Remarks Wildcat

Brack - Contr.

Spudding Date 1-11-55

Drlg. Data D & A TD 3785

8" @ 258 Heeb. 3392 Tor. 3412

Lans. 3439 Arb. 3678 TD 3785

DST 3682-96 open 1 hr. Rec. 45' socm

430# DST 3696-3718 open 1 hr. Rec.

96' wm 900#

D & A

FABEN GILSTRAP