


KANSAS

Section 27 Township 14 Range 13-W

Well No. #4 H. Rein

Company Continental
(Hall Gurney)

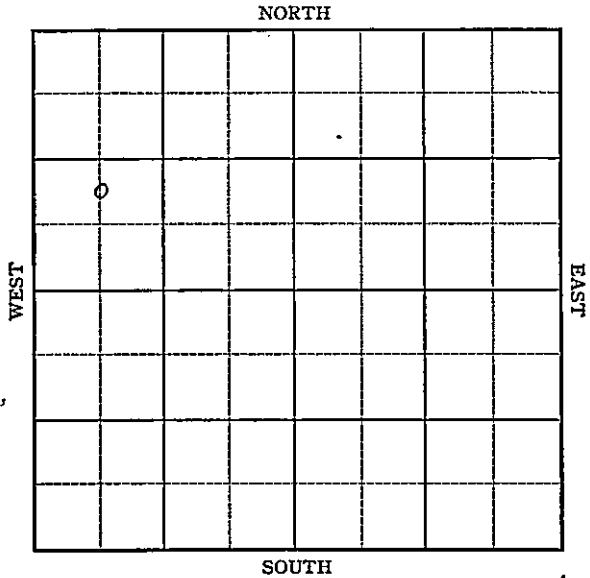

Map No. _____ Sec. 27 Twp. 14 R. 13WWell No. 4 H. Rein

Continental

Company

Contractor

FIRST REPORT

SECTION PLAT

C N L SW NW

_____ Ft. from N. Line

990 Ft. from S. Line

_____ Ft. from E. Line

660 Ft. from W. Line

HALL GURNEY POOL

o			

Location _____

Rig up _____

Drilling and Remarks:

Rotary

RECORD

Cased _____ in., _____ ft.

Sand _____

Gas _____

Oil _____

Total Depth _____

PRODUCTION

1st 24 hrs. Nat. _____

1st 24 hrs. after shot _____

Gas _____ Cu. Ft.

Dry Hole _____

Abandoned _____

Date

Jul 30 1941 19S. J. LEWIS Scout

Map No. _____ Sec. 27 Twp. 14 R. 13W

Well No. 4 H. Rein

Continental Company

COMPLETED Contractor

C N L SW NW

SECTION PLAT

_____ Ft. from N. Line

990 Ft. from S. Line

_____ Ft. from E. Line

660 Ft. from W. Line

o			

HALL GURNEY POOL

Location _____

Rig up _____

Drilling and Remarks:

*Loss 2576
6" @ 2894
6000 acial
Pump 505 P.D.
37 E Se*

RECORD

Cased _____ in., _____ ft.

Sand _____

Gas _____

Oil _____

Total Depth 2915

PRODUCTION

1st 24 hrs. Nat. _____

1st 24 hrs. after shot _____

Gas _____ Cu. Ft.

Dry Hole _____

Abandoned _____

Date

AUG 27 1941 19

S. J. LEWIS

Scout