


LOCATION NOTICE

TULSA, OKLA., April 7, 1952, 19.....

WELL NO. 12 ON William Letsch FARM

WILL BE AS FOLLOWS:

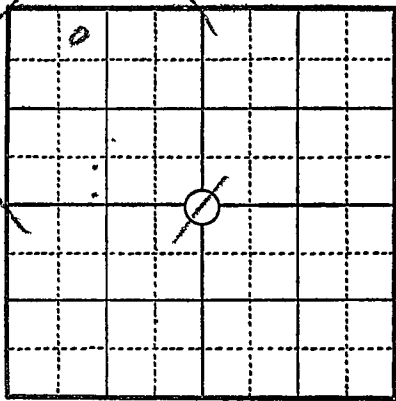

..... 330 FEET FROM NORTH LINE
 FEET FROM EAST LINE
 FEET FROM SOUTH LINE
 990 FEET FROM WEST LINE

IN. NW/4 SEC. 26 TWP. 14S RANGE 13W
Russell COUNTY, STATE OF Kansas

REMARKS. R. L. Mankey -- Dist. Supt.
R. O. Bobey -- Foreman
M. C. P. C. - 100%

SIGNED A. E. Pierce

COPIES TO

- R. W. McDOWELL
- DISTRICT SUPT.
- ACCOUNTING DEPT.
- ✓ SCOUTING DEPT.
- GEOLOGICAL DEPT.
- PIPE LINE DEPT.
- MATERIALS DEPT.
- RENTAL DEPT.
- LEGAL DEPT.
- LEO MEYER
- INCOME TAX DEPT.
- ENGINEERING DEPT.
- LEASE INVENTORY
- CLAIM DEPT.
- J. W. BASORE
- FILE

w

Card Lippid
mm

BP