


Section 26 Township 14 Range 13W

Well No. #1 Shaffer

Company G M R Oil

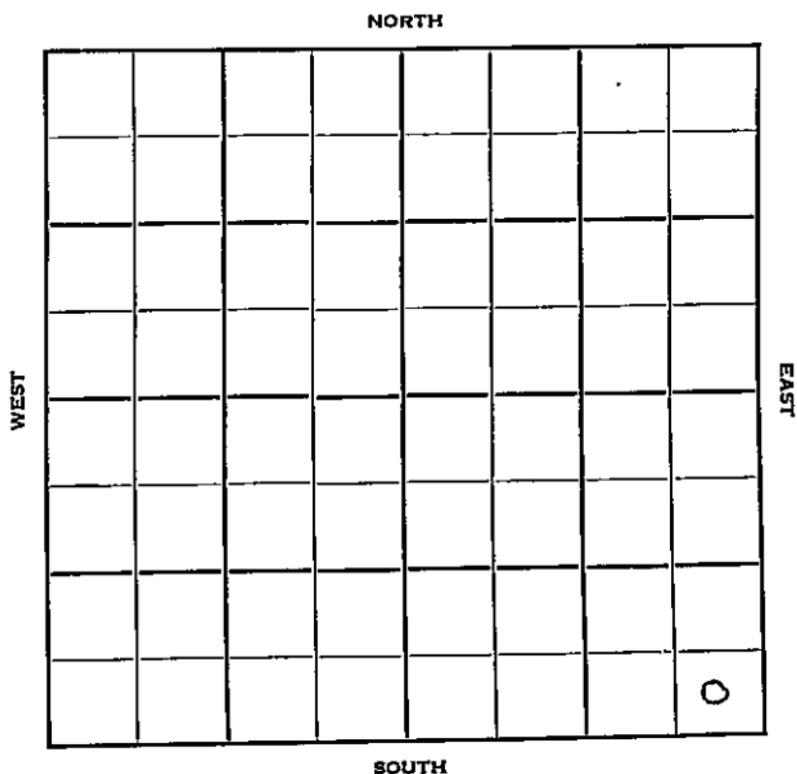

Russell

KANSAS ✓

Sec. 26 Twp. 14 R. 13W

Well No. #1 Shaffer Farm

G-M-R Oil Company

Lohman & Johnson Contractor


_____ Ft. from N. Line

330 Ft. from S. Line

330 Ft. from E. Line

_____ Ft. from W. Line

SE $\frac{1}{4}$ SE SE SE

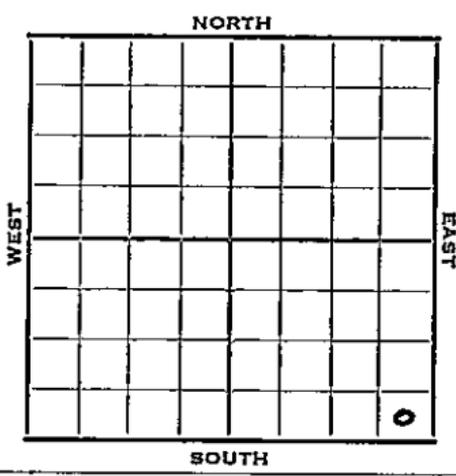

1952 Elev. 1685' REPORT

10/22 Spud 10-20-52
8" @ 295'

10/29 1st Tarkio 2170' 2nd Tarkio 2193'
Willard sd 2250-2320 RTD 4" @ 2320

11/5 CO 15/ 2275-80 15/ 2259-74
4 galwph 24/ 2219-28 24/ 2203-16
Sd-Frac S/ 2 Boph Dec. to 1/2
BO & 1/2 Bwph

11/12 Spud 10-20-52
D & A TD 2320' 8" @ 295'
1st Tarkio 2170' 2nd Tarkio 2193'
Willard sd 2250' TD 2320' 4" @ 2320
15/2275-80 15/2259-74 4 GOPH
24/2219-28 24/2203-16 sd-frac.
S/2 BOPH dec. to $\frac{1}{2}$ BOPH $\frac{1}{2}$ BW
S/2 $\frac{1}{4}$ BO 3 BW 12 hrs.
D & A

ABANDONED

