
FORM 51 25M 3-49 PETROL **KANSAS** Russell

Section 6 Township 15 Range 14-W

Well No. #1 Vonfelt

Company J W Chenoweth

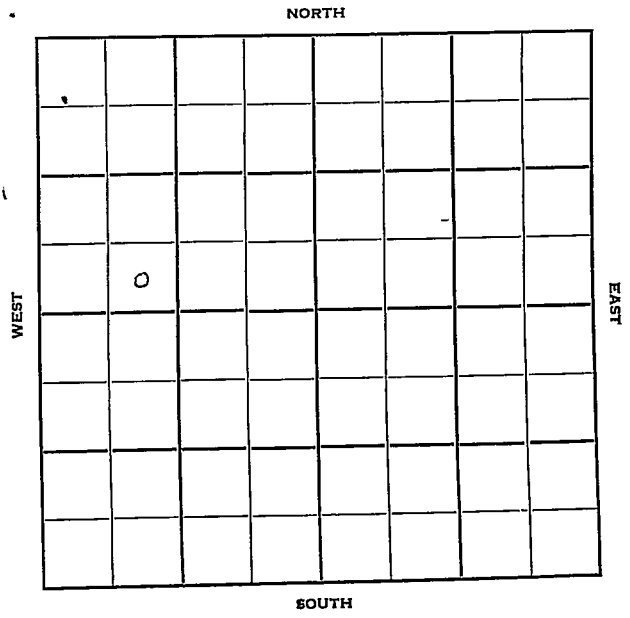

FORM 252-B
10M 9-49 PETROL

KANSAS Russell

Sec. 6 Twp. 15 R. 14-W

Well No. #1 Vonfelt Farm

J. W. Chenoweth Company

Sterns Drlg. Contractor

Big Creek


____ Ft. from N. Line

330 Ft. from S. Line

____ Ft. from E. Line

990 Ft. from W. Line

SE SW NW

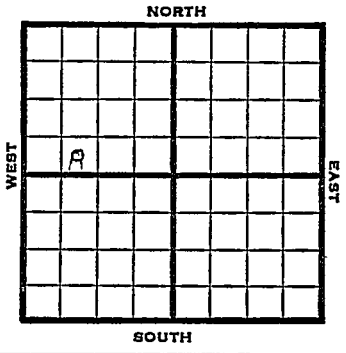

1950	Elev 1729	REPORT
6/7	Rig Up	
8/16	Anhy 750 8 5/8" @ 757 Lans 2920 TD 2956 1000 A FU 800' oil 12 hr Comp 50 bopd Completed COMPLETED	

Form 26 200 Bks. 11-49 Petrol Kansas Big Creek

Map No. _____ Sec. 6 Twp. 15 R. 14W

Well No. 1 Vonfelt

J. W. Chenoweth Company

Sterns Drlg. Contractor

SE SW NW

SECTION PLAT

FIRST REPORT			
o			

_____ Ft. from N. Line

330 Ft. from S. Line

_____ Ft. from E. Line

990 Ft. from W. Line

Russell

Location _____

Rig up X

Drilling and Remarks:

RECORD

Cased _____ in., _____ ft.

Sand _____

Gas _____

Oil _____

Total Depth _____

PRODUCTION

1st 24 hrs. Nat. _____

1st 24 hrs. after shot _____

Gas _____ Cu. Ft.

Dry Hole _____

Abandoned _____

Date

JUN 7 1950 19

J. E. TYRA Scout

FORM 275 FOR SALE BY KANSAS BLUE PRINT CO.


County Russell State Kansas

Sec. 6 (Blk. / Twp.) 15 (Sur. / Rge.) 14W Map No.

Operator J. W. Chenoweth

Well No. 1 Farm Vonfelt

Elev. 1729 Location SE SW NW

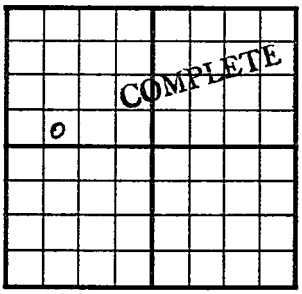

330 Ft. From S Line NW

990 Ft. From W Line Quarter

1st. Report

Completion AUG 16 1950

Remarks

Spudding Date

Drlg. Data Oil Well TD 2956

Anhy 750 8 5/8" @ 757 Lans. 2920

TD 2956 1000 A FU 800' oil 12 hr.

Comp. 50 bopd

J. E. TYRA