

LOCATION NOTICE


June 18

7

TULSA, OKLA.193.....

WELL NO. **One (1)** ON **William Letsch** FARM

WILL BE AS FOLLOWS:

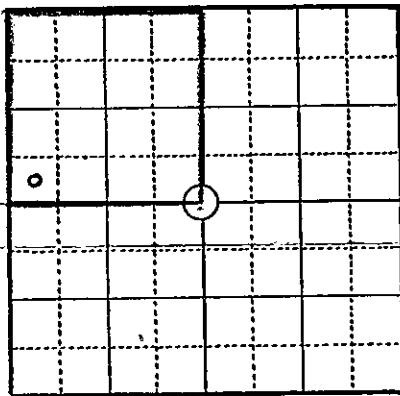

..... FEET FROM NORTH LINE

..... FEET FROM EAST LINE

550' FEET FROM SOUTH LINE

350' FEET FROM WEST LINE

IN **NW 1/4** SEC. **26** TWP. **14S** RANGE **13W**

Russel COUNTY, STATE OF **Kansas**

REMARKS: **MOPU interest All.**

Foreman - E.A. Dymond.

COPIES TO

SIGNED _____

- DISTRICT SUPT.
- ACCOUNTING DEPT.
- RENTAL DEPT.
- SCOUTING DEPT.
- ENGINEERING DEPT.
- LEGAL DEPT.
- CLAIM DEPT.
- TAX DEPT.
- GEOLOGICAL DEPT.
- FILE
- LEASE INVENTORY

[Handwritten signatures and scribbles]

[Handwritten signature]


[Handwritten signature]

O. W. P. B. LOCATION NOTICE PLUG BACK

TULSA, OKLA., March 27, 1952, 19.....

WELL NO. 1 ON William Letsch FARM

WILL BE AS FOLLOWS:

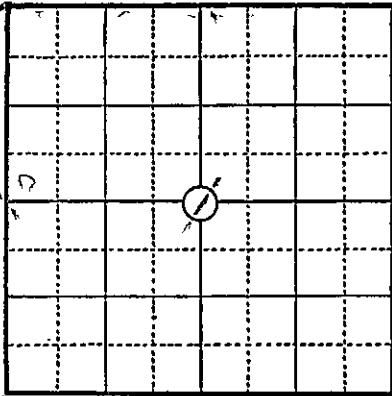

..... FEET FROM NORTH LINE
 FEET FROM EAST LINE
 330 FEET FROM SOUTH LINE
 330 FEET FROM WEST LINE
 IN N7/4 SEC. 26 TWP. 14S RANGE 13W
Russell COUNTY, STATE OF Kansas

REMARKS: R. I. Mankoy - Dist. Supt.
R. O. Bobey - Foreman
Plug back and test shallower sand.

SIGNED A. E. Pierce

COPIES TO

- R. W. McDOWELL
- DISTRICT SUPT.
- ACCOUNTING DEPT.
- SCOUTING DEPT.
- GEOLOGICAL DEPT.
- PIPE LINE DEPT.
- MATERIALS DEPT.
- RENTAL DEPT.
- LEGAL DEPT.
- LEO MEYER
- INCOME TAX DEPT.
- ENGINEERING DEPT.
- LEASE INVENTORY
- CLAIM DEPT.
- J. W. BASORE
- FILE

*OWPB card Pulled +
new dope put on.
mm*

