

Section 26 Township 14 Range 13W

Well No. #12 Letsch

Company Mid-Continent Pet. Corp.

NORTH

	0						

WEST

EAST

SOUTH

HOT FILE

Russell, KANSAS

Sec. 26 Twp. 14 S R. 13 W

Well No. #12 Wm. Letsch Farm

Mid-Continent Pet. Corp. Company

Barnett Drlg. Contractor


340' Ft. from N. Line

Ft. from S. Line

Ft. from E. Line

1000' Ft. from W. Line

NE NW NW

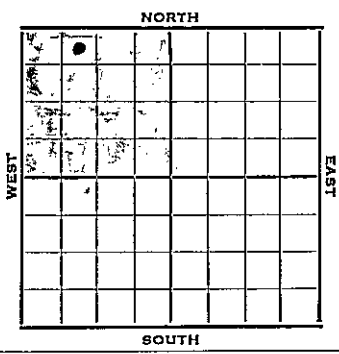

1952	Elev. 1708'	REPORT
4/7		Location Notice
4/7		Spudding today. DR
4/8		Spudded 4-7-52. Set 8-5/8" csg. @ 220' w/75 sax. TD-220'. DR
4/9		Drlg. 655'. DR
4/10		Drlg. 1480'. DR
4/11		Drlg. 1812'. DR
4/14		Set 5 1/2" @ 2315' w/75 sax. TD-2320'. DR
4/15		TD-2320'. W.O.C. DR
4/16		TD-2320'. W.O.C. DR
4/17		TD-2320', MICT. DR
4/18		TD-2320'. MICT. DR
4/21		TD-2320'. Perforating. Cleaning out. DR
4/22		TD 2320'. Preparing to treat w/hydrafrac. DR
4/23		TD-2320'. Preparing to treat with Hydrafrac. DR
4/24		TD-2320'. Opened after Hyfrac. Rec. load. Swbg. 4 bph after load recovered. DR
4/25		TD-2320'. MI pumping unit. DR
4/28		TD2320'; Setting pumping unit. DR
4/29		TD-2320'. Setting pumping unit. DR
4/30		" " " " " DR
5/1		" " " " " DR
		Tarkio 2206'

5/2 TD-2320', Setting pumping unit.
5/5 " " " " "
5/6 COMP. 5-6-52. 20 bpd. Pumping.
TD-2320'.
5/13 No report
5/21 Spud 4-7-52
Oil Well TD 2320' 8" @ 214
5" @ 2320' TD 2320'
Tar 2206 8/ 2204-06 24/ 2219-22
102/ 2238-55 Hydro.
Comp. 28 bopd 12 bw

DR
BE
DR

COMPLETED

County **Russell** State **Kansas**Sec. **26** (Blk.) **14** (Sur.) **13W** Map No.
(Twp.) (Rge.)Operator **Mid-Continent Petroleum Corp.**Well No. **12** Farm **Letsch**Elev. Location **NE NW NW**

0					

340 Ft. From **N** Line **NW**1000 Ft. From **W** Line QuarterIst. Report **APR 9 1952**

Completion

Remarks

Spudding Date **4-7-52**

Drlg. Data

8" @ 214' W/175**J. G. McGEHEE**

County Russell State Kansas

Sec. 26 (Blk. Twp.) 14 (Sur. Rge.) 13W Map No.

Operator Mid-Continent Petroleum Corp.

Well No. 12 Farm Letsch

Elev. 1708 Location NE NW NW

o							

340 Ft. From N Line NW

1000 Ft. From W Line Quarter

Ist. Report

Completion MAY 21 1952

Remarks Hall-Gurney Pool

Spudding Date 4-7-52

Drilg. Data Oil well TD 2320

8" @ 214 5" @ 2320 TD 2320

Tarkio 2206 8/ 2204-06 24/ 2219-22

102/ 2238-55 Hydro. Comp. 28 hord 12 b