


Section 26 Township 14 Range 13W

Well No. #13, Letsch

Company Texon

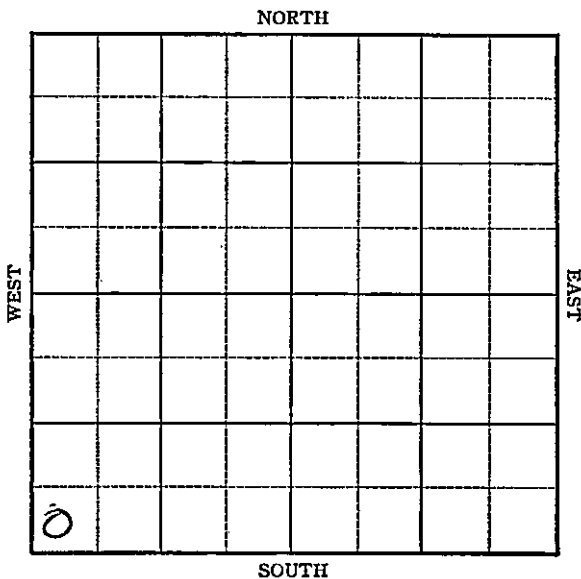

Sec. 26 Twp. 14 R. 13W

Well No. #13 Letsch Farm

Texon Company

Hall-Gurney


_____ Ft. from N. Line

330 Ft. from S. Line

_____ Ft. from E. Line

330 Ft. from W. Line

SW/o

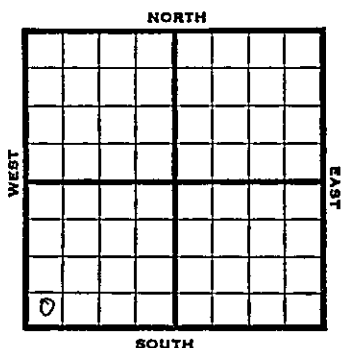

1946 Elev 1692' REPORT

5/1 RUR

5/7 10" @ 220
Drlg 731'

5/14 Drlg 2434'

5/21 TD 2940'
7" @ 2939, RUST

5/29 7" @ 2936
TD 2937' corrected.
98 shots 2880-2914 4050 acid.
SSO

6/5 84 shots 2816-2820
Pump 175 oil 20 hrs.

6/19 Lans 2801'
7" @ 2936
Perf
4000 acid
Pump 292 oil plus 33 W Pot
39.0 Gr
TD 2937'

COMPLETED

