


Section 26 Township 11 Range 13 W

Well No. #3 Shaffer

Company Mast Drlg.

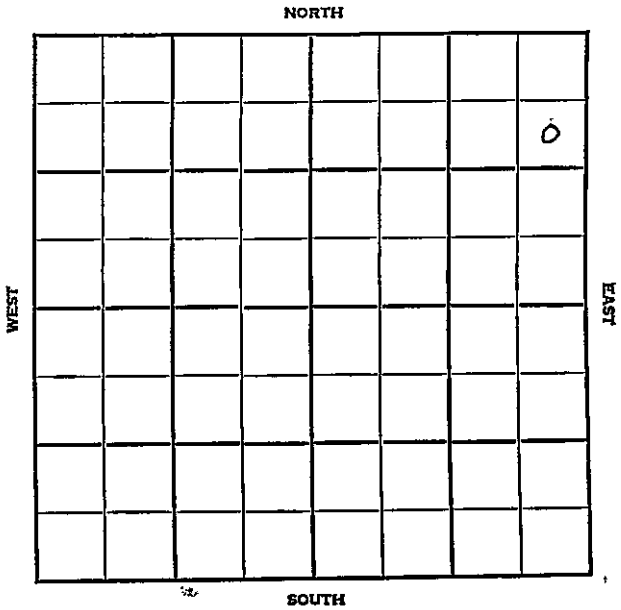

Russell

KANSAS

SEC. 26	TWP. 14	R. 13W
------------	------------	-----------

WELL NO.

#3 Shaffer

FARM

COMPANY

Mast Drlg.

CONTRACTOR

Co. Tools

Hall-Gurney


Ft. from N. Line

Ft. from S. Line

Ft. from E. Line

Ft. from W. Line

SE NE NE

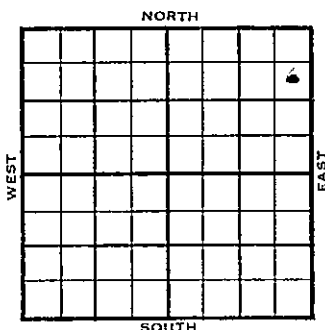

1955	ELEVATION 1715'	REPORT FIRST REPORT																
8/10	Comm 8-6-55 8" @220/135 Drlg: 1005 Anh: 644																	
9-7	5 1/2" @ 2335 32/2220-24 2250 acid Frac swb load Swb load POP Pmp 35 bopd 20% wtr.																	
	<table><tr><th><u>TOPS</u></th><th><u>DEPTH</u></th></tr><tr><td>Anh.</td><td>644</td></tr><tr><td>Tark</td><td>2214</td></tr><tr><td>Tp</td><td>2545</td></tr><tr><td>Hb</td><td>2781</td></tr><tr><td>Tr</td><td>2800</td></tr><tr><td>L.</td><td>2854</td></tr><tr><td>C.</td><td>3144</td></tr></table>	<u>TOPS</u>	<u>DEPTH</u>	Anh.	644	Tark	2214	Tp	2545	Hb	2781	Tr	2800	L.	2854	C.	3144	
<u>TOPS</u>	<u>DEPTH</u>																	
Anh.	644																	
Tark	2214																	
Tp	2545																	
Hb	2781																	
Tr	2800																	
L.	2854																	
C.	3144																	
	T.D. 3186'																	
		COMPLETED																

DX-78

COMPLETED

County Russell Elev. _____
 Sec. 26 Twp. 14 Rgs. 13W
 Company Mast Drlg.
 Farm Name Shaffer No. 3

TOPS	DEPTH	LOG	DATUM
Anh.	644		
Tr.			
H.			
Tr.			
Dg.			
BL.			
L.			
K.C.			
B.K.C.			
Ce.			
C.			
M.			
M.			
K.			
Mz.			
Me.			
V.			
S.			
S.			
A.			
R.			
Pe.			
G.			
T.D.			

Loc. in Sec. _____

SE NE NE

Geol. _____

Contr. _____

Co. tools _____

Pool _____

Hall-Gurney

AUG 10 '55

FIRST REPORT

Date Comm. 8-6-558" @ 220/135 drlg. 1005

13

County Russell Elev. 1715
 Sec. 26 Twp. 14 Rge. 13W
 Company Mast Drlg.
 Farm Name Shaffer No. 3

TOPS	DEPTH	LOG	DATUM	Loc. in Sec.
Anh.	644			SE NE NE
Ep. <u>Tark</u>	2214		499	
H. <u>Ip</u>	2545		830	
Tr. <u>Hb</u>	2781		1066	
Dg. <u>Tr</u>	2800		1085	
Bl.				
L.	2854		1139	
K.C.				Geol.
B.K.C.				Contr.
Ce.				
C.	3144		1429	Co. tools
M.				Pool
M.				Hall-Gurney
K.				
Mz.				
Mo.				
V.				
S.				
S.				
A.				
R.				
PE.				
G.				
T.D.	3186			COMPLETE

Date Comm. 8/6/55 SEP 7 1955

8" 220 w/135 5 $\frac{1}{2}$ " 2335 32/2220-24
 2250 acid Frac swb load Swb load POP
 Pmp 35 bopd 20% wtr