

WEST

EAST

SOUTH

Drilling Remarks

Drilling Remarks

RECORD

Cased.....in.ft.

Sand

Gas -----

Oil _____

Total Depth.....

PRODUCTION

1st 24 hrs. Nat.

1st 24 hrs. after shot.....

Gas..... cu. ft.

Dry Hole

Abandoned -----


Map No. **KANSAS** Sec. 8 Twp. 29R 8
 Well No. 1-Nelson Farm
Shawver et al Company

330 Ft. from N. Line

_____ Ft. from S. Line

330 Ft. from E. Line

_____ Ft. from W. Line

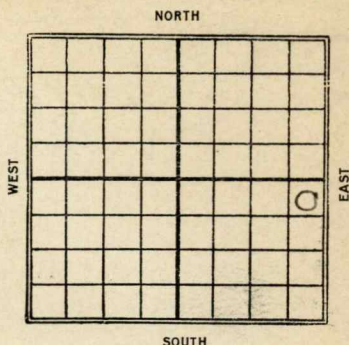

1928

Date

REPORT

2/15	Rigging up
2/13	Spudding
3/1	Drlg - 600
3/8	12"-1282 - drlg 1285-
3/16	Drlg - 1665-
3/22	" 1930
3/29	H.F.W. 2140 - straightreaming
4/5	Dry Sand 2545-55
	drilling 2620-
4/12	Topline 2687-drlg 2780-
4/19	Drlg 3108-
4/26	Dry Sand 2545-55 -
	top line 2687 - H.F.W. 3105 -
	Shut down 3118-
5/3	Top line 2687-HFW
	at 3105 D+Q 3118

10 **KANSAS** Sec. 8 Twp. 29 R. 8 E
 Map No. 1 Nelson
 Well No. *Shawver* at #1 Company _____ Contractor _____

FIRST REPORTS

330 Ft. from N. Line
 _____ Ft. from S. Line
 330 Ft. from E. Line
 _____ Ft. from W. Line

SECTION PLAT

			o

Location _____

Rig up _____

Drilling and Remarks:

*Rigging up***RECORD**

Cased _____ in., _____ ft.

Sand _____

Gas _____

Oil _____

Total Depth _____

PRODUCTION

1st 24 hrs. Nat. _____

1st 24 hrs. after shot _____

Gas _____ Cu. Ft.

Dry Hole _____

Abandoned _____

Date

FEB 15 1928

CHAS. L. SHERWOOD

192

Scout

Butler
 10 KANSAS 8 Twp. 29 R. 8
 Map No. Sec. Twp. R.
 Well No. 1 Nelson
 shawyer et al Company

Contractor

COMPLETED

SECTION PLAT

330 Ft. from N. Line

Ft. from S. Line

330 Ft. from E. Line

Ft. from W. Line

ABANDONED,

			o

Location

Rig up

Drilling and Remarks:

Top hump 2687

AFW 3105'

D&W 3118

RECORD

Cased in., ft.

Sand

Gas

Oil

Total Depth 3118

PRODUCTION

1st 24 hrs. Nat.

1st 24 hrs. after shot

Gas Cu. Ft.

Dry Hole ✓

Abandoned ✓

Date

MAY 3 1928 CHAS. L. SHERWOOD

192

Scout