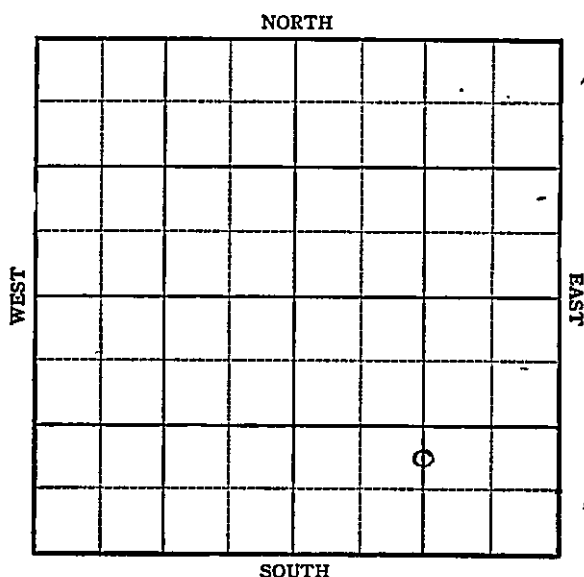


KANSAS

Russell County

Section 31 Township 14 Range 13WWell No. #3, MillerCompany R. H. Shields

KANSAS

Russell

Sec. 31 Twp. 14 R. 13W

Well No. #3 Miller Farm

R H Shields Company

Hall-Gurney


NORTH

 Ft. from N. Line

990 Ft. from S. Line

1320 Ft. from E. Line

 Ft. from W. Line

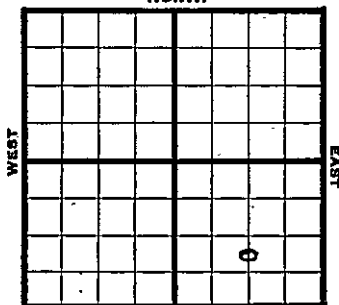

C N L $\frac{5}{2}$ SE

1944

REPORT

8/23

Lans 2875

7" @ 2875

P B 2927

5000 Acid

Pump 448 oil plus 44% W Pet

TD 2991


COMPLETED

Pool Name Hall-GurneyMap No. KANSAS Sec. 31 Twp. 14 R. 13WWell No. 3 MillerR. H. Shields

Company

FIRST REPORT

Contractor

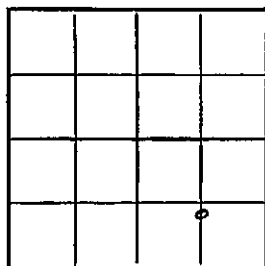C N L S $\frac{1}{2}$ SE**COMPLETED****SECTION PLAT** Ft. from N. Line990 Ft. from S. Line1320 Ft. from E. Line Ft. from W. LineRussell CountyLocation Rig up

Drilling and Remarks:

Lans. 28757" - 2875P B 29275000 acidPump 448 oilplus 44% W Pet**RECORD**Cased in., ft.Sand Gas Oil Total Depth 289'**PRODUCTION**1st 24 hrs. Nat. 1st 24 hrs. after shot Gas Cu. Ft.Dry Hole Abandoned

Date

AUG 23 1944 19S. J. LEWIS

Scout