


O. W. P. B.

Section 26 Township 14 Range 13-W

Well Number 1 - W. Letsch

Company Mid-Cont. Pet.

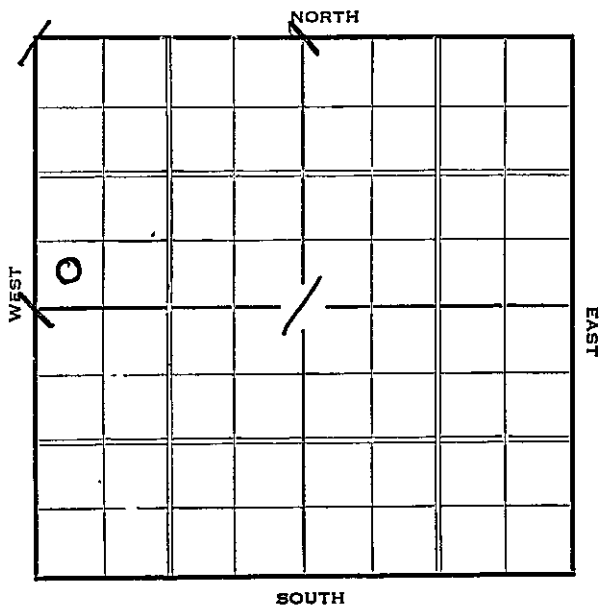

Sec. 26 Twp. 14 R. 13-W

Well No. #1 W. Letsch Farm

Mid-Cont. Pet. Company


 Ft. from N. Line

330 Ft. from S. Line

 Ft. from E. Line

330 Ft. from W. Line

Elev. 1719

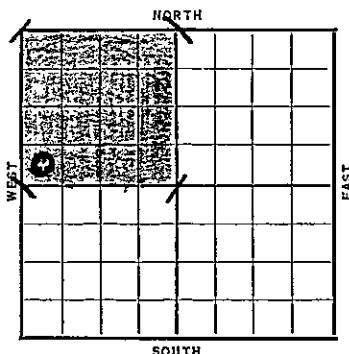

Date	REPORT
1937	
6/23	B. R. R.
7/2	S. H.
7/6	Drlg. 1140 ^r yesterday. (Tel).
7/8	12" 223 Dlg. 1650 (Tel) --
7/10	Dlg. 2150 (Tel)
	Expect Oswald 2800 to 2900
7/14	T.D. 2010 Lost circulation (Tel)
7/15	Dlg. 2568 (Tel)
7/16	T.D. 2771 Lost circulation (Tel)
7/18	Top Kansas City 2850
	slight saturation 2855-2858
	T.D. 2858 Set 7" at top (Telegram)
	Running 6 feet higher than Shields
	#1 Letsch---southwest offset which was
	completed for 1293 bbls. (Willson)
7/19	7" 2851 WOC (Tel)
7/22	Rust Drill cement tomorrow (Tel)
7/23	Will start drilling plugs this
	afternoon (Tel)

OVER

OVER

7/26--Top Kansas City 2850
Slight saturation 2855-58
T.D. 2858 7" 2851 Rust
Increase in oil 2864-69
Increase in oil 2888-94
T.D. 2895 in line
Filled up 1800 feet oil in 16 hours
Will swab and clean out Run tubing
and acidize
Will be around Thursday or Friday before
taking potential
Estimate around 2000 bbl. well (Tel)

7/26--Swabbed 95 bbls. and swabbed down
After swabbing down swab 8 to 10 bbls.
per hour natural Will swab until get
enough oil for acid load then acidize
with 6000 gallons (Tel)

7/30--Acidized with 6000 gallons
Will take potential tomorrow (Tel)

7/31--Will take potential today (Tel)

~~EXXX~~

7/31--Pumped 498 Barrels 1st 4 hours on Pot.
Pumped 504 " Next 4 " " "
24 Hour Potential 2,991 Barrels (Tel)

8/4 7" @ 2851'.
K. C. 2850'.
T.D. 2895'.
6000 acid.
Pumped & flowed 1st 4 hrs. 498.47 bbls.
2nd 4 hrs. 503.80 bbls.
Pot. 2991 bbls.

COMPLETED

1938

1/26--Took new potential 3077 bbls.
1st 4 hrs was 530 bbls.
2nd 4 hrs was 512 bbls. (Tel)

1 W. Letsch

O. W. P. B.

€ = * * *

1952

3/27

Plug back & test shallower sand.

(Location Notice

Russell KANSAS

Map No. 72 Sec. 26 Twp. 14 R. 13 WWell No. 1 - W. LetschMid - Cont. Pet Company

Contractor

FIRST REPORT

SECTION PLAT

_____ Ft. from N. Line

330 Ft. from S. Line

_____ Ft. from E. Line

330 Ft. from W. Line

Location _____

Rig up _____

Drilling and Remarks:

B.R.R.

RECORD

Cased _____ in., _____ ft.

Sand _____

Gas _____

Oil _____

Total Depth _____

PRODUCTION

1st 24 hrs. Nat. _____

1st 24 hrs. after shot _____

Gas _____ Cu. Ft.

Dry Hole _____

Abandoned _____

Date

JUN 23 1937 19

H. D. Hatfield Scout

Russell **KANSAS**Map No. _____ Sec. 26 Twp. 14 R. 13 ^WWell No. 1 - W LetschMid-Cont Pet. Company

Contractor

COMPLETED**SECTION PLAT**

_____ Ft. from N. Line

330 Ft. from S. Line

_____ Ft. from E. Line

530 Ft. from W. Line

0			

Location _____

RECORDCased 7 in., 2851 ft.Sand K.C. 2850

Gas _____

Oil _____

Total Depth 2895**PRODUCTION**

1st 24 hrs. Nat. _____

1st 24 hrs. after shot _____

Gas _____ Cu. Ft.

Dry Hole _____

Abandoned _____

Drilling and Remarks:

6000 acidPumped & Flowed1st 4 hrs 498.472nd ✓ 503.80Pat - 2991

Date

AUG 4 - 1937 19

H. D. Hatfield

Scout