

Sec. 25 Twp. 14 R. 13W ✓

Well No. 10 Goodheart Farm

Texas Company


Hall-Gurney Pool

330 Ft. from N. Line

_____ Ft. from S. Line

990 Ft. from E. Line

_____ Ft. from W. Line

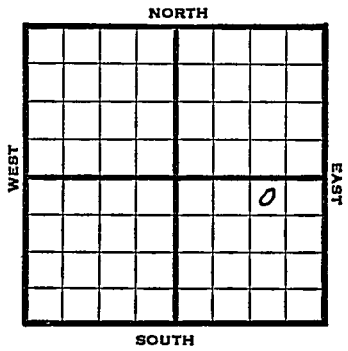

NW NE SE

1948 Eli 1673' REPORT

9/22 Location
 9/29 "
 10/6 "
 10/13 "
 10/19 10"@ 622'
 10/26 Drlg 2718'
 11/3 Lansing 2826'
 TD 2828'
 7" @ 2827'
 11/10 TD 2908'
 3000 acid
 Swb 23 bbls oil PH - 12 hrs
 11/16 "
 11/23 TD 2908'
 Lansing 2826'
 7"@ 2827'
 3000 acid
 Pump 205 Oil Pot
 40⁹ Gr.
 Comp
COMPLETED

Map No. 72 Sec. 25 Twp. 14 R. 13W

Well No. 10 Goodheart

Texas Company

COMPLETE Contractor

NW NE SE

E11628

SECTION PLAT

330 Ft. from N. Line

_____ Ft. from S. Line

990 Ft. from E. Line

_____ Ft. from W. Line

			6

Russell County

Location _____

Rig up _____

Drilling and Remarks:

Loss 2526
7" 02827
3000 acid
Pump 205 illud
40 E. B.

RECORD

Cased _____ in., _____ ft.

Sand _____

Gas _____

Oil

Total Depth 2905'

PRODUCTION

1st 24 hrs. Nat. _____

1st 24 hrs. after shot _____

Gas _____ Cu. Ft.

Dry Hole _____

Abandoned _____

Date _____

_____ 19____

S. J. LEWIS Scout