


Section 25 Township 14 Range 13-W

Well No. #1 H. A. Rogg

Company Sidey etal

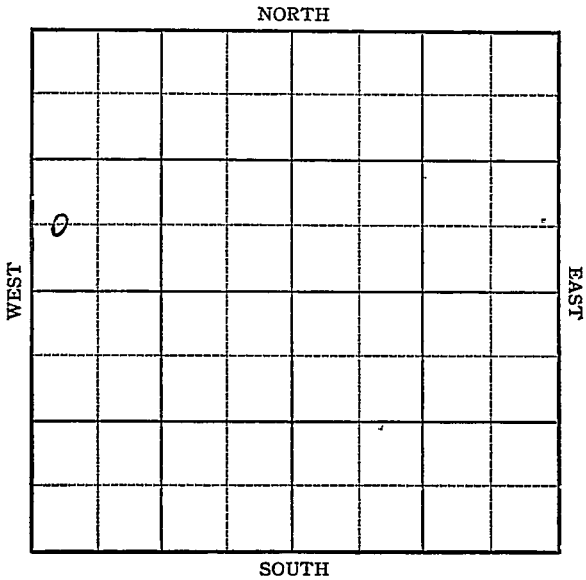


Sec. 25 Twp. 14 R. 13-W

Well No. #1 H. A. Rogg Farm

Sidey etal Company

NORTH

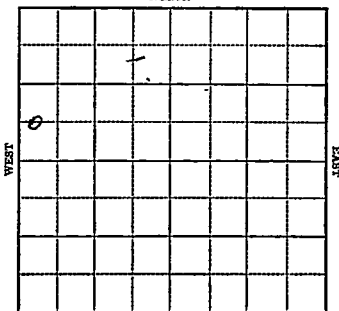

_____ Ft. from N. Line

660 Ft. from S. Line

_____ Ft. from E. Line

330 Ft. from W. Line

Elev. 1710

1943

R E P O R T

10/6

Location

10/13

Cable rig

10/20

13" @ 288
12" @ 335
Drlg. 480

10/27

10" @ 35'
Anhy 635
Drlg. 1500'

11/3

Drlg. 2265
Run 8"

11/10

Drlg. 2565'
8" @ 2365'

11/17

7" @ 2880
TD 2910'

WOC

12-1

7" @ 2880
Lans 2861
TD 2910
8000 Acid
Pump 250 Pot.
Gravity 39.2

COMPLETED

KANSAS

Map No. 72 Sec. 25 Twp. 14 R. 13W

Well No. I H. A. Rogg

Sidey et al. Company

FIRST REPORT Contractor

C W L SW NW

SECTION PLAT

_____ Ft. from N. Line

660 Ft. from S. Line

_____ Ft. from E. Line

330 Ft. from W. Line

o			

Hall-Gurney Pool

Location X

Rig up _____

Drilling and Remarks:

Cable Rig

RECORD

Cased _____ in., _____ ft.

Sand _____

Gas _____

Oil _____

Total Depth _____

PRODUCTION

1st 24 hrs. Nat. _____

1st 24 hrs. after shot _____

Gas _____ Cu. Ft.

Dry Hole _____

Abandoned _____

Date

OCT 6 1943 19

S. J. LEWIS Scout

Map No. KANSAS Sec. 25 Twp. 14 R. 13W

Well No. 1 H. A. Rogg

Sidey et al. Company

COMPLETED Contractor

C W L SW NW

SECTION PLAT

_____ Ft. from N. Line

660 Ft. from S. Line

_____ Ft. from E. Line

330 Ft. from W. Line

o			

Hall-Gurney Pool

Location _____

Rig up _____

Drilling and Remarks:

Lans 2861

7" @ 2880.

5000 acid

Pump 250 P.S.

392/4

RECORD

Cased _____ in., _____ ft.

Sand _____

Gas _____

Oil _____

Total Depth 2910

PRODUCTION

1st 24 hrs. Nat. _____

1st 24 hrs. after shot _____

Gas _____ Cu. Ft.

Dry Hole _____

Abandoned _____

Date

DEC 1 1943 19

S. J. LEWIS Scout