


KANSAS

Map No. \_\_\_\_\_ Sec. 12 Twp. 29 R. 8

Well No. 2 Porter Farm \_\_\_\_\_

Roth Chas Company \_\_\_\_\_

NORTH

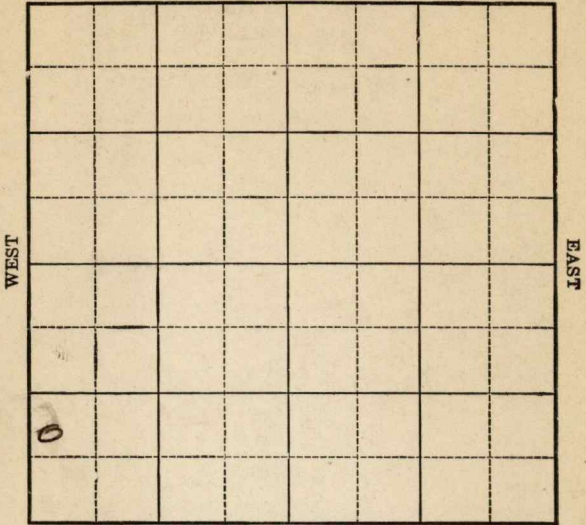

SOUTH

Location \_\_\_\_\_

Drilling Remarks:

\_\_\_\_\_

\_\_\_\_\_

Rig Up \_\_\_\_\_

Drilling Remarks:

\_\_\_\_\_

\_\_\_\_\_

RECORD

Cased \_\_\_\_\_ in. \_\_\_\_\_ ft.

Sand \_\_\_\_\_

Gas \_\_\_\_\_

Oil \_\_\_\_\_

Total Depth \_\_\_\_\_

PRODUCTION

1st 24 hrs. Nat. \_\_\_\_\_

1st 24 hrs. after shot \_\_\_\_\_

Gas \_\_\_\_\_ cu. ft.

Dry Hole \_\_\_\_\_

Abandoned \_\_\_\_\_

Map No. \_\_\_\_\_ Sec. 12 Twp. 29 R. 8

Well No. J Porter Farm  
Roth Schal Company

\_\_\_\_\_ Ft. from N. Line

760 Ft. from S. Line

\_\_\_\_\_ Ft. from E. Line

200 Ft. from W. Line



1/24

REPORT

2045-74-JL.  
shot 140/200 Rbls

Map No. KANSAS 10 Sec. 12 Twp. 29 R. 8

Well No. 2 Porter

Rath et al Company

Contractor

**FIRST REPORT  
COMPLETED**

**SECTION PLAT**


\_\_\_\_\_ Ft. from N. Line

760 Ft. from S. Line

\_\_\_\_\_ Ft. from E. Line

200 Ft. from W. Line

Location \_\_\_\_\_

Rig up \_\_\_\_\_

Drilling and Remarks:

2045-74 J.D.  
140/200 lbs.

**RECORD**

Cased \_\_\_\_\_ in., \_\_\_\_\_ ft.

Sand \_\_\_\_\_

Gas \_\_\_\_\_

Oil \_\_\_\_\_

Total Depth \_\_\_\_\_

**PRODUCTION**

1st 24 hrs. Nat. \_\_\_\_\_

1st 24 hrs. after shot \_\_\_\_\_

Gas \_\_\_\_\_ Cu. Ft.

Dry Hole \_\_\_\_\_

Abandoned \_\_\_\_\_

Date

**FEB 4** 1924

**M. A. BENEAR**

Scout