


Section 25 Township 14 Range 13W

Well No. 12 Goodheart

Company Texas

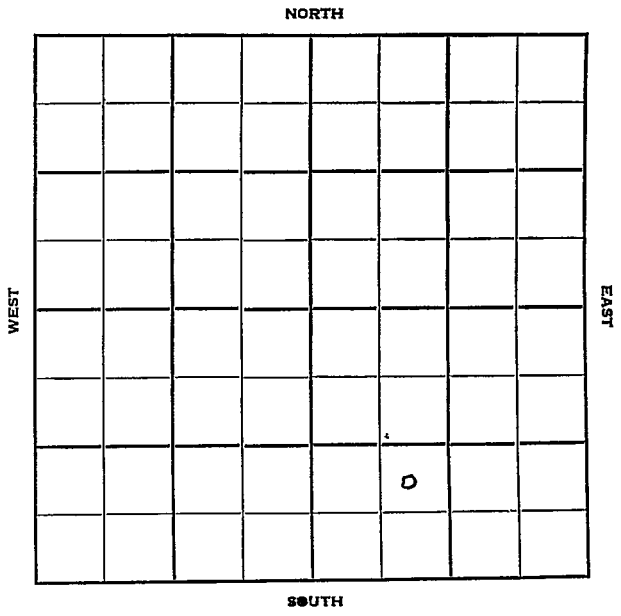

Russell

KANSAS ✓

Sec. 25 Twp. 14 R. 13 W

Well No. # 12 Goodheart Farm

Texas Company

Hall-Gurney Pool Contractor


 Ft. from N. Line

990 Ft. from S. Line

 Ft. from E. Line

990 Ft. from W. Line

NE SW SE

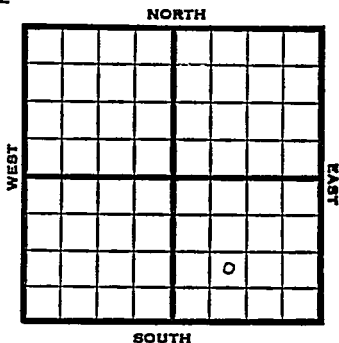

1951

Elev. 1678' REPORT

7/25

Pits

9/5

Spud 7-25-51
 SWD Well TD 3291
 10" @ 644
 Top. 2493 Br Lime 2813
 KC 2830
 DST 2839-60 opn 1 hr Rec. 210' gas
 70' gcm & socm Arb. 3105
 DST 3113-51 opn 1 hr Rec. 650' w
 & ocm 1750' o & gcm 60' wtr
 Gr Wash 3284 TD 3291
 7" @ 3170 5000A Input 1,800 bswpd

ABANDONED

