

KANSAS

Form 51-5M-7-40-Palace


Russell

Section 25 Township 14 Range 13-W

Well No. #1 Weimeister

Company Cities Service Oil


NORTH Hall Burney Pool

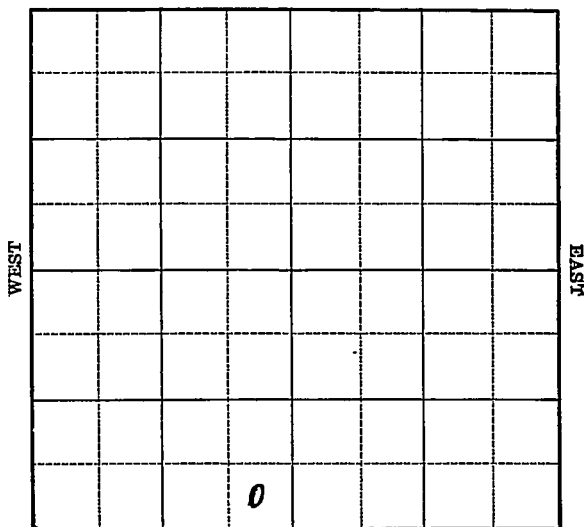

SOUTH

Sec. 25 Twp. 14 R. 13-WWell No. #1 Weimeister FarmCities Service Oil Company
(Hall Gurney) Ft. from N. Line330 Ft. from S. Line330 Ft. from E. Line Ft. from W. Line

Elev. 1668

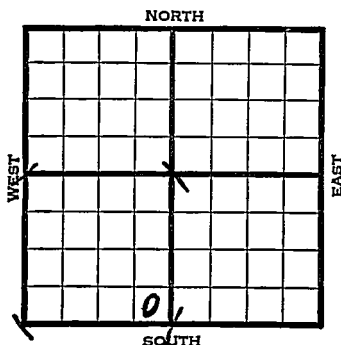

1941	REPORT
3/19	Rig on ground.
3/27	8" - 355' Drlg. 600'
4/2	Lans. ²⁸⁰⁹ 2807 - 28' T.D. 5" - ²⁸²⁹ 2807
	RUST.
4/10	Lans. 2809' (Corrected)
	5" - 2829' T.D. 3040'
	Fighting cave.
4/18	Arb. 3101-05'
4/24	T.D. 3105' 340' of 4½" liner on bottom.
5/1	Pump 413 bbls.
5/7	Lans. 2809'
	5" - 2829'
	Arb. 3101'
	4" liner 3102½'
	T.D. 3105'
	Potential 413 bbls., pump.
	38.3 Gravity
	OVER


Map No. 72 Sec. 25 Twp. 14 R. 13WWell No. 1 WeimeisterCities Service Oil Company~~FIRST REPORT~~ Contractor

SE SW

 Ft. from N. Line330 Ft. from S. Line330 Ft. from E. Line Ft. from W. Line

HALL GURNEY POOL

SECTION PLAT

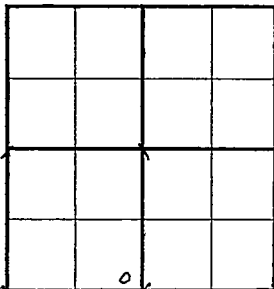Location Rig up

Drilling and Remarks:

Rig on Ground

RECORD

Cased in., ft.Sand Gas Oil Total Depth

PRODUCTION

1st 24 hrs.-Nat. 1st 24 hrs. after shot Gas Cu. Ft.Dry Hole Abandoned

Date

MAR 19 1941

19


S I LEWIS Scout

Map No. 72 Sec. 25 Twp. 14 R. 13WWell No. 1 WeimeisterCities Service Oil CompanyCOMPLETED Contractor

SE SW

 Ft. from N. Line330 Ft. from S. Line330 Ft. from E. Line Ft. from W. Line

SECTION PLAT

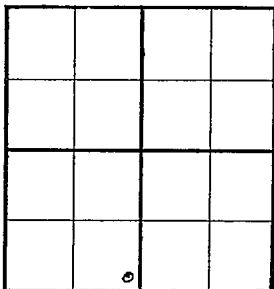

HALL GURNEY POOL

Location Rig up

Drilling and Remarks:

*Loss 2809**5" @ 2829**Cu. 3101**4" liner 3102 1/2**Pump 4130 2 1/2**38 1/2 Gr.*

RECORD

Cased in., ft.Sand Gas Oil Total Depth 3105

PRODUCTION

1st 24 hrs. Nat. 1st 24 hrs. after shot Gas Cu. Ft.Dry Hole Abandoned

Date

MAY 7 1941₁₉S. J. LEWIS Scout