

Butler


DX 78-1

KANSAS

Section 17 Township 29 Range 8E

Well No. #4 Hoard "B"

Company Beaumont

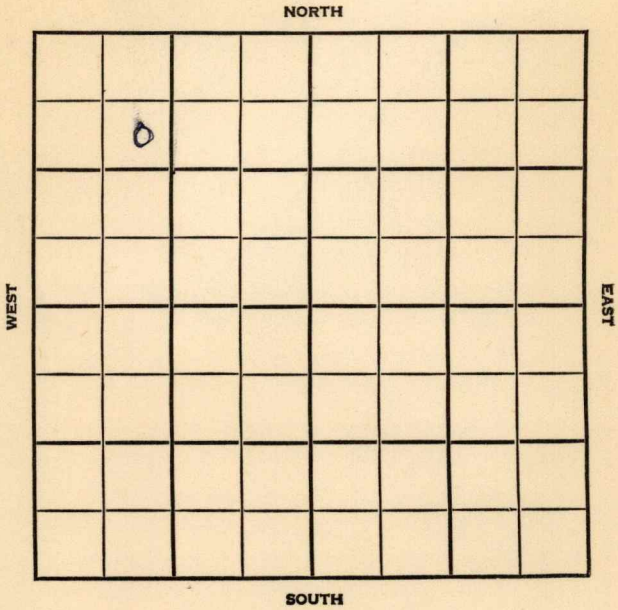

County Butler Elev. _____
Sec. 17 Twp. 29 Rge. 8E
Company Beaumont
Farm Name Hoard "B" No. 4

TOPS	DEPTH	LOG	DATUM
Anh.			
T.P.			
H.			
Tr.			
Dg.			
B.L.			
L.			
K.C.			
B.K.G.			
Ce.			
C.			
M.			
M.			
K.			
Mz.			
Me.			
V.			
S.			
S.			
A.			
R.			
Pc.			
G.			
F.D.			

Loc. in Sec.
SE NW NW

Geol. _____
Contr. _____
Co. Tools
Pool
Shinn

FIRST REPORT			
NOV 14 '56			

Date Comm. Spd. 11-9-56
8" @ 48, Drlg. 1540

May 2 0 1956

County Butler Elev. 1545 DF
 Sec. 17 Twp. 29 Rge. 8E
 Company Beaumont
 Farm Name Hoard "B" No. 4

TOPS	DEPTH	LOG	DATUM	Loc. in Sec.
Anh.				SE NW NW
TP.				
H.				
Tr.				
Dg.				
Bl.				
L.				
K.C. <u>X</u>	<u>1939</u>			Geol.
B.K.C.	<u>2175</u>			Contr.
Ce. <u>Marm</u>	<u>2268</u>			Co. Tools
C. <u>esh</u>	<u>2423</u>			
M. <u>09</u>	<u>2696</u>			Pool
M. <u>L1</u>	<u>2707</u>			Shinn
K. <u>Miss Polo</u>	<u>2747</u>			
Mz.				
Ma.				
V.				
S.				
S.				
A.				
R.				
PE.				
G.				
TD.	<u>2833</u>			

COMPLETE

JAN 16 '57

Date Comm. spd. 11-9-568" @ 48, Drlg. 1540 NOV 21 '56 X 5 1/2 @ 2833NOV 28 '56 WOCT DEC 5 '56 CO 2816 24/2789-93 12/2782-85 S.O.10/2778-80 PB 2773 84/2759-71 FU 285' oil no/w 12 hrs12 DEC 12 '56 50d 2759-71 CODEC 19 '56 DEC 26 '56 CO 2816 11/2tstg JAN 2 '57 tstg. JAN 9 '57 no incFrac. JAN 16 '57 P. & Bopd + 35 Bwdd