

Butler

KANSAS

SECTION 17 TOWNSHIP 29 RANGE 8 E

WELL NO. #1 Wehrman

COMPANY C. L. Carlook

NORTH

				0			

WEST

EAST

SOUTH

Butler

KANSAS

SEC.	TWP.	R.
17	29	8E
WELL NO.		

#1 Wehrman

FARM

COMPANY

~~C.L. Carlock~~

CONTRACTOR

B & C Tools

WILDCAT


Ft. from N. Line

Ft. from S. Line

Ft. from E. Line

Ft. from W. Line

SW SW NE

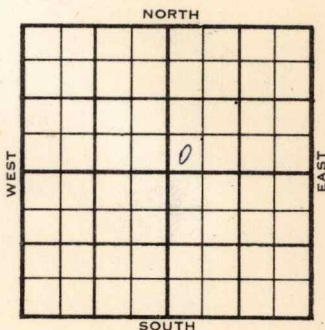

Ohio BHAP

	ELEVATION	REPORT
1956	1495 RB, 1489 DF	

1-25

Comm. 1-20-56

8" @ 102/100

DST 1605-25 op 1 hr. rec. 65' msw,
405/20"

Drlg. 1750

Layton 1602'

5-29

5½" @ 2697

DD # 2715

B/ 1 boph, 1000 A , 1½ boph,

P/ 2½ boph, 8 hrs.

P/ 12 bopd,

P/ 8 bopd, frac

P/ 7 bopd, 20% wtr.

Comp. 25 bopd, 10 bw

Layton 1602! M. 2680'.

TD 2700'

COMPLETED

CORRECTION

FORM 513 REV. SUNRAY

County Butler Elev. 8E
Sec. 17 Twp. 29 Rge. 8E
Company J. P. Gaty
Farm Name Wehrman No. 1

TOPS	DEPTH	LOG	DATUM
Anh.			
Tp.			
H.			
Tr.			
Dg.			
Bl.			
L.			
K.C.			
B.K.C.			
Ce.			
C.			
M.			
M.			
K.			
Mz.			
Me.			
V.			
S.			
S.			
A.			
R.			
Pe.			
G.			
T.D.			

Loc. in Sec. SW SW NE

Geol.
Contr.

Pool

	0	

CORRECTION

Date Comm. MAY 29 1956

Reported C. L. Carlock #1 Wehrman

1495 RB

1489 DF

County

Butler

Elev.

Sec.

17

Tw.

29

Rge.

8E

Company

J. P. Gaty

Farm Name

Wehrman

No.

1

TOPS	DEPTH	LOG	DATUM	Loc. in Sec.
Anh.				SW SW NE
Tp.				
H.				
Tr.				
Dg.				
Bl.				
L. Layton	1602		113	Geol.
K.C.				Contr.
B.K.C.				B & C tools
Ce.				
C.				Pool
M.	2680		1191	Wild cat
M.				
K.				
Mz.				
Mq.				
V.				
S.				
S.				
A.				
R.				
Pc.				
G.				
T.D.	2700			

COMPLETE

Date Comm. 1-20-56

MAY 29 1956

8" @ 102/100 DST 1605-25 open 1 hr.

rec. 65' msu 405/20" 5 1/2" @ 2697

DD 2715 B/ 1 boph 1000 A 1 1/2 boph

P/ 2 1/2 boph 8 hr. P/ 12 bopd

P/ 8 bopd frac P/ 7 bopd 20% wtr.

Comp. 25 bopd 10bw

County Butler Elev. 1495 RB
 Sec. 17 Twp. 29 Rge. 1489 DF
 Company C. L. Carlock
 Farm Name Wehrman No. 1

TOPS	DEPTH	LOG	DATUM	Loc. in Sec.
Anh.				SW SW NE
Tp.				
H.				
Tr.				
Dg.				
Bl.				
L. <u>Layton</u>	<u>1602</u>			Geol.
K.C.				Contr.
B.K.C.				B & C tools
Ce.				Pool
C.				Wildcat
M.				
M.				
K.				
Mz.				
Mq.				
V.				
S.				
S.				
A.				
R.				
Pe.				
G.				
T.D.				

FIRST REPORT
 JAN 25 '56

Date Comm. 1-20-56 Ohio BHAP
8" @ 102/100 DST 1605-25 open 1 hr.
rec. 65' msu 405/20" drlg. 1750