

KANSAS

Map No. 2 Sec. 19 Twp. 29 R. 0

Well No. J Hanna Farm

Company

NORTH

WEST

EAST

SOUTH

Location _____

Drilling Remarks:

Rig Up _____

Drilling Remarks:

RECORD

Cased _____ in. _____ ft.

Sand _____

Gas _____

Oil_____

Total Depth_____

PRODUCTION

1st 24 hrs. Nat. _____

1st 24 hrs. after shot_____

Gas _____ cu. ft.

Dry Hole _____

Abandoned_____

Map No. 1 Sec. 14 Twp. 29 R. 8


Well No. 2 Hanna Farm
Booth et al. Company

200 Ft. from N. Line

_____ Ft. from S. Line

1120 Ft. from E. Line

Ft. from W. Line

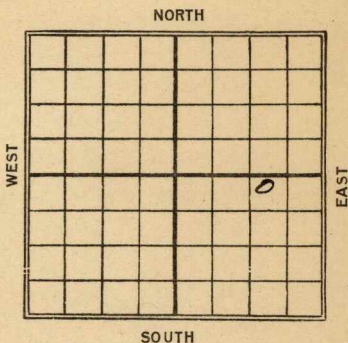

Date	REPORT
7/19	Dug up
4/24	Rig
7/16	D. 2950'
10/8	S. & Q. 3207

Map No. **KANSAS** ¹⁰ Sec. **14** Twp. **29** R. **8**Well No. **#2 Hanna**
Rath et al Company

Contractor

FIRST REPORT

SECTION PLAT

200 Ft. from N. Line

Ft. from S. Line

1120 Ft. from E. Line

Ft. from W. Line

			0

Location

Rig up **✓✓**

Drilling and Remarks:

RECORD

Cased _____ in., _____ ft.

Sand _____

Gas _____

Oil _____

Total Depth _____

PRODUCTION

1st 24 hrs. Nat. _____

1st 24 hrs. after shot _____

Gas _____ Cu. Ft.

Dry Hole _____

Abandoned _____

Date

M. A. BENEAR**FEB 1 1924**

192

Sc

1510 KANSAS Sec. 14 Twp. 29 R. 8

Well No. 2 Hanna

Rath et al. Company

Contractor

ABANDONED SECTION PLAT

200 Ft. from N. Line

Ft. from S. Line

1120 Ft. from E. Line

Ft. from W. Line

			0

Location

Rig up

Drilling and Remarks:

LP + d
3207

RECORD

Cased _____ in., _____ ft.

Sand _____

Gas _____

Oil _____

Total Depth _____

PRODUCTION

1st 24 hrs. Nat. _____

1st 24 hrs. after shot _____

Gas _____ Cu. Ft.

Dry Hole _____

Abandoned _____

Date

OCT 8 1924

192

M. A. BENEAR

Scout