
Form 51-5M-12-36 Com'l

Russell KANSAS

Section 31 Township 14 Range 13-W

Well Number 6 Miller

Company Smokey Hill

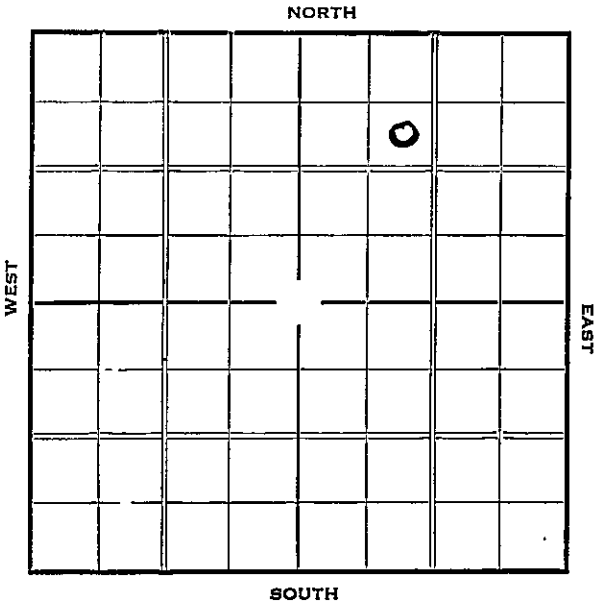

Form 252-A—5M—2-37—Palace— KANSAS Russell

Sec. 31 Twp. 14 R. 13-W

Well No. #6 Miller- Farm


Smokey Hill Company

990 Ft. from N. Line

Ft. from S. Line

Ft. from E. Line

990 Ft. from W. Line

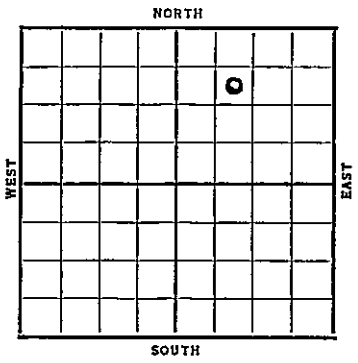

Elev. 1717

Date	REPORT
1937	
3/31	Drlg. 325'.
4/8	12" @ 335', 10" @ 659'
	Drlg. 1300'
4/16	Drlg. 2170'
4/23	Topeka 2500'.
	Show oil 2580'. Drlg. 2760'.
4/30	Oswald 2850'. 6" @ 2850'.
	Drlg. 2918'.
5/5	Oswald 2846'.
	T.D. 2950'.
	8000 acid.
	Pot. 1023.
	COMPLETED

Form 26—1M Bks.—2-29 KANSAS Russell


Map No. _____ Sec. 31 Twp. 14 R. 19W

Well No. 6 Miller

Smokey Hill Company

_____ Contractor

SECTION PLAT

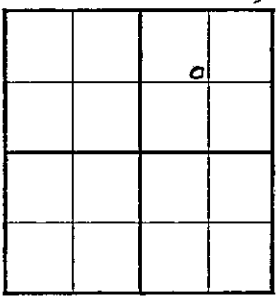

990 Ft. from N. Line

_____ Ft. from S. Line

_____ Ft. from E. Line

990 Ft. from W. Line

FIRST REPORT

Location _____

Rig up _____

Drilling and Remarks:

July 825

RECORD

Cased _____ in., _____ ft.

Sand _____

Gas _____

Oil _____

Total Depth _____

PRODUCTION

1st 24 hrs. Nat. _____

1st 24 hrs. after shot _____

Gas _____ Cu. Ft.

Dry Hole _____

Abandoned _____

Date

MAR 31 1937

_____ 19 _____

S. J. LEWIS Scout

Form 26—1M Bks.—2-29 Russell KANSAS

Map No. 72 Sec. 31 Twp. 14 R. 13 W

Well No. 6 - Miller

Smokey Hill Company

Contractor

COMPLETED


990 Ft. from N. Line

Ft. from S. Line

Ft. from E. Line

990 Ft. from W. Line

SECTION PLAT

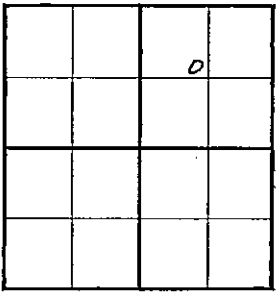

Location

Rig up

Drilling and Remarks:

8000 Acid

Pot 1023

RECORD

Cased in., ft.

Sand Oswald 2846

Gas

Oil

Total Depth 2950

PRODUCTION

1st 24 hrs. Nat.

1st 24 hrs. after shot

Gas Cu. Ft.

Dry Hole

Abandoned

Date MAY 5 - 1937 19

W. D. Hatfield Scout