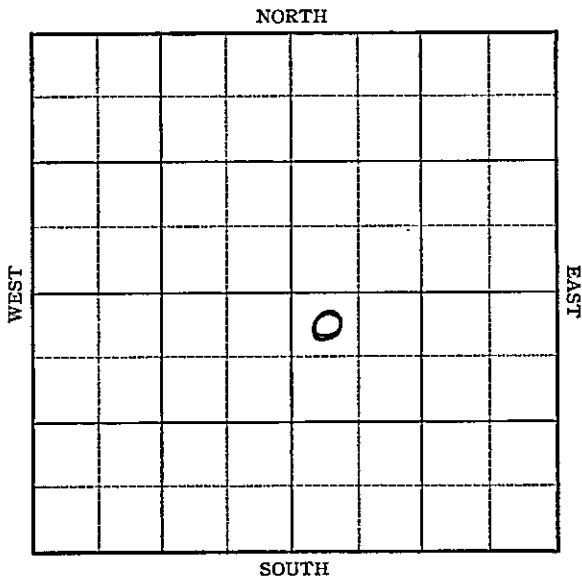
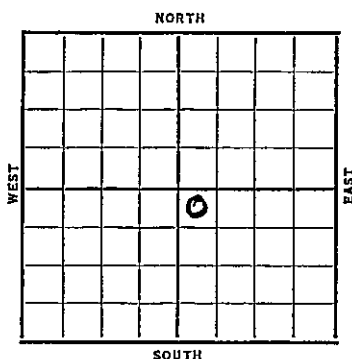


Section 31 Township 14 Range 13-WWell No. 1 - Miller "D"Company Cities Service Oil

KANSAS

Russell

Sec. 31 Twp. 14 R. 13-WWell No. #1 Miller "D" FarmCities Service Oil Company330 Ft. from N. Line Ft. from S. Line Ft. from E. Line330 Ft. from W. Line

Date

REPORT

1937

9/1 12" @ 360'. WOC.

9/10 Drlg. 1826'.

9/17 K.C. 2831'. 7" @ 2835'.

No shows reported. RUST.

9/24 S.O. 2844-50'. Drlg. 2853'.

10/2 T.D. 2921'. 1900' oil 29 hrs.

10/8 5000 acid.

10/13 7" @ 2835'.

Oswald 2831'.

T.D. 2921'.

5000 acid.

Pump 269 bbls. 4 hrs & 157 bbls. 4 hrs.

Potential 942 bbls.

COMPLETED

KANSAS

Russell

Map No. _____ Sec. 31 Twp. 14 R. 13WWell No. 1- Miller "D"Cities Service Oil Company

Contractor _____

FIRST REPORT

SECTION PLAT

330 Ft. from N. Line

_____ Ft. from S. Line

_____ Ft. from E. Line

330 Ft. from W. Line

		0	

Location _____

Rig up _____

Drilling and Remarks:

12" - 360 WOC

RECORD

Cased _____ in., _____ ft.

Sand _____

Gas _____

Oil _____

Total Depth _____

PRODUCTION

1st 24 hrs. Nat. _____

1st 24 hrs. after shot _____

Gas _____ Cu. Ft.

Dry Hole _____

Abandoned _____

Date

SEP 1 1937 19

H. D. Hatfield Scout

Russell KANSAS

Map No. _____ Sec. 31 Twp. 14 R. 13WWell No. 1 Miller "D"Cities Service

Company

Contractor

COMPLETED

NW SE

330 Ft. from N. Line

_____ Ft. from S. Line

_____ Ft. from E. Line

330 Ft. from W. Line

SECTION PLAT

		0	

Location _____

Rig up _____

Drilling and Remarks:

5000 AcidP- 269/4 & 157/4POT- 942

RECORD

Cased 7 in., 2835 ft.Sand Qswald 2831

Gas _____

Oil _____

Total Depth 2921

PRODUCTION

1st 24 hrs. Nat. _____

1st 24 hrs. after shot _____

Gas _____ Cu. Ft.

Dry Hole _____

Abandoned _____

Date

OCT 13 1937H. D. Hatfield

Scout