


Section 17 Township 29 Range 8E

Well No. #2 Wehrman

Company Beaumont Petr.

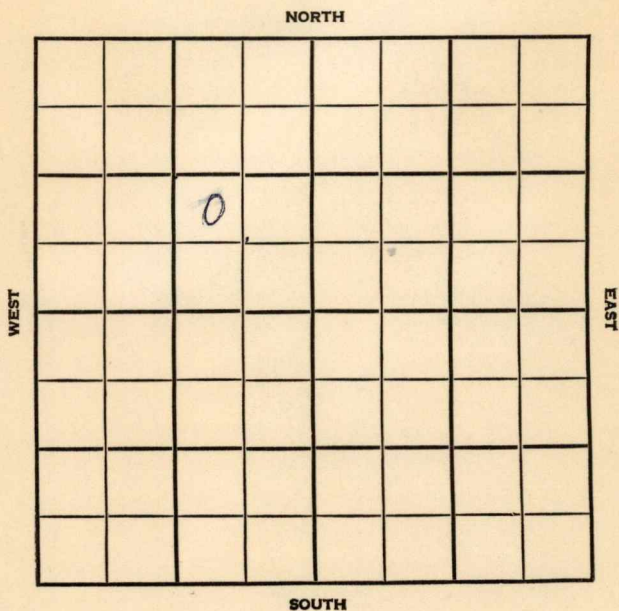

County Butler Elev. _____
 Sec. 17 Twp. 29 Rge. 8E
 Company Beaumont Petroleum
 Farm Name Wehrman No. 2

TOPS	DEPTH	LOG	DATUM
Anh.			
Tp.			
H.			
Tr.			
Dg.			
Bl.			
L.			
K.C.			
B.K.C.			
Ce.			
C.			
M.			
M.			
K.			
Mz.			
Mq.			
V.			
S.			
S.			
A.			
R.			
Pf.			
G.			
T.D.			

Loc. in Sec. _____
 NW SE NW
 Geol. _____
 Contr. _____
 Co. Tools _____
 Pool _____
 Shinn NE



Date Comm. _____
 Location _____

NOV 5 1988
 R.G.

Handwritten signature in red ink.

Co.
Lse.
No.
Sec.
T.
R.

County Butler Elev. 1517 RB
 Sec. 17 Twp. 29 Rge. 8E
 Company Beaumont Petroleum
 Farm Name Wehrman No. 2

TOPS	DEPTH	LOG	DATUM	Loc. in Sec.																
Anb.				NW SE NW																
Tr.																				
Dg.																				
Bl.																				
L.				Geol.																
K.C.	1920			Contr.																
B.K.C.	2154			Co. Tools																
C.	Marm 2253			Pool																
M.	ce 2410			Shinn NE																
M.	2700			<table border="1"> <tr> <td></td> <td></td> <td></td> <td></td> </tr> <tr> <td></td> <td></td> <td>NOV 23 '56</td> <td></td> </tr> <tr> <td colspan="2"></td> <td>COMPLETE</td> <td></td> </tr> <tr> <td></td> <td></td> <td></td> <td></td> </tr> </table>							NOV 23 '56				COMPLETE					
		NOV 23 '56																		
		COMPLETE																		
K.																				
Mz.																				
Me.																				
V.																				
S.																				
S.																				
A.																				
R.																				
PE.																				
G.																				
TD	2825																			

Date Comm. _____
 Location Oct 31 '56 10-24-56 10" @
40 @ 2369 NOV 7 '56 7" @ 2825 NOV 13 '56
DST 2755-66 1hr 210' 9554 oil
80' VHO CM + 40' SW NO DHP. NOV 21 '56
X PF 25/2775-77 N P. 20
Bopd no/wtr. Miss PF 2775
-77 RTD 2825
complete