


KANSAS

Section 25 Township 14 Range 13W

Well No. #5 Weinmeister

Company Cities Service

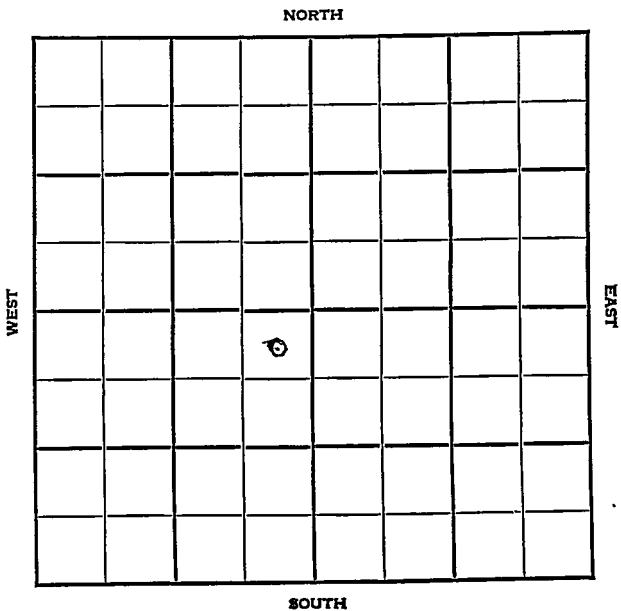



Sec. 25 Twp. 14 R. 13W

Well No. #5 Weinmeister Farm


Cities Service Company
Hall-Burney

330 Ft. from N. Line

_____ Ft. from S. Line

330 Ft. from E. Line

_____ Ft. from W. Line

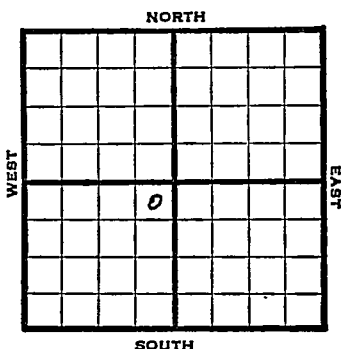

NE SW

1948 Elev. 1698' REPORT

1/14 RUR

1/21 Drlg. 2022'

1/26 Arbuckle 3130'-33'
TD 3133'
Ruq 4"

2/4 Topeka 2533'
Lansing 2844'
Conglomerate 3124'
65 shots. 2544-75'
32 shots. 2611-19' - 500 acid.

2/11 1000 acid 2544-68'
Swb. 5½ W in 24 hrs.

2/18 57 shots 2881-95'
1000 acid
Pump 2 bbls oil / 21 W in 24 hrs.

2/25 Squeeze Perf.

3/3 Topeka 2533'
Lans. 2844'
Cong. 3124'
4" @ 3131'
Perf. Lans.
500 Acid
Pump 269 oil / 7% W
Gr. 40°
Total Depth 3134'
COMPLETED

Map No. _____ Sec. 25 Twp. 14 R. 13W

Well No. 5 Weinmeister

Cities Service Company

FIRST REPORT

Contractor

NE SW

SECTION PLAT

330 Ft. from N. Line

_____ Ft. from S. Line

330 Ft. from E. Line

_____ Ft. from W. Line

	Δ		

Russell County

Location _____

Rig up _____

Drilling and Remarks:

R U R

RECORD

Cased _____ in., _____ ft.

Sand _____

Gas _____

Oil _____

Total Depth _____

PRODUCTION

1st 24 hrs. Nat. _____

1st 24 hrs. after shot _____

Gas _____ Cu. Ft.

Dry Hole _____

Abandoned _____

Date

JAN 14 1948 19

S. J. LEWIS Scout