
FORM 51 5M 2-38 TPCO. Russell KANSAS

Section 31 Township 14 Range 13W

Well No. 3 Schnoor

Company Texas

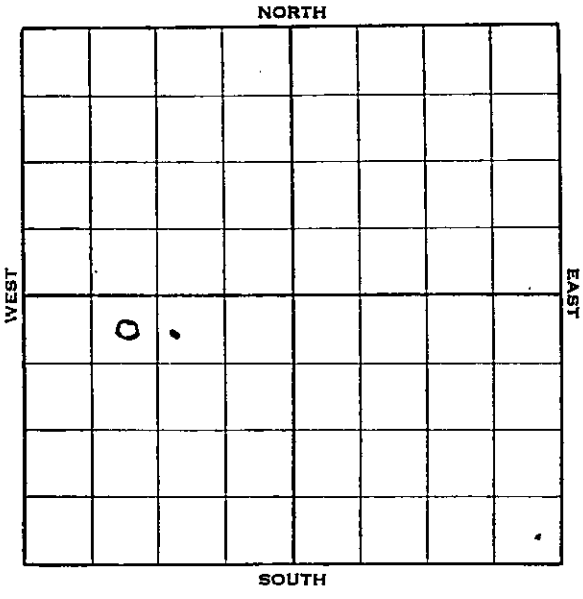

Form 252-A—5M—9-37 KANSAS Russell

Sec. 31 Twp. 14 R. 13-W

Well No. #3 Schnoor Farm

Texas Company


330 Ft. from N. Line

Ft. from S. Line

Ft. from E. Line

990 Ft. from W. Line

Elev. 1743

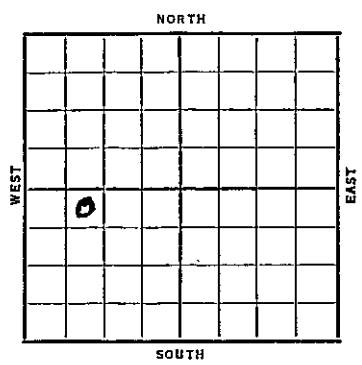

Date	REPORT
1938	
2/9	G. R.
2/18	RUCT
2/26	15" @ 22'. Drlg. 235'.
3/4	Drlg. 900'.
3/11	12" @ 330'. Anhy. 689'.
	10" @ 695'. Drlg. 1820'.
3/18	8" @ 2347'. Drlg. 2445'.
3/25	S.O. & G 2280-85'.
	8" @ 2412'. Drlg. 2635'.
4/1	Dodge 2886'. S.O. 2873'.
	Lans. 2938'. 6" @ 2943'.
	1/2 Bailer oil 2976-81'.
	Drlg. 3061'. 1000' oil with
	S. W.
4/8	5" @ 3172'. Gorham 3211-13' T.D.
	600' oil 8 hrs. Cleaning out.
4/15	5" @ 3186'. T.D. 3216'.
	2800' oil. Cleaning out.
4/22	5" @ 3208'. Cleaning out.
	OVER

1938

4/27 5" @ 3208'.

Gorham 3211'.

T.D. 3218'.

Potential 370 bbls.

COMPLETED

Form 26—1M Bks.—2-29 Russell KANSAS

Map No. ____ Sec. 31 Twp. 14 R. 13W

Well No. 3 Schnoor

Texas Company

Contractor

FIRST REPORT

NE NW SW


330 Ft. from N. Line

____ Ft. from S. Line

____ Ft. from E. Line

990 Ft. from W. Line

SECTION PLAT

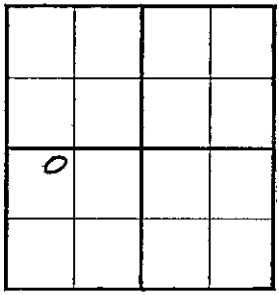

Location ____

Rig up ____

Drilling and Remarks:

CR

RECORD

Cased ____ in., ____ ft.

Sand ____

Gas ____

Oil ____

Total Depth ____

PRODUCTION

1st 24 hrs. Nat. ____

1st 24 hrs. after shot ____

Gas ____ Cu. Ft.

Dry Hole ____

Abandoned ____

Date

FEB 9 1919

H. D. Hatfield Scout

Form 26—1M Bks.—2-29

Russell KANSAS

Map No. 72 Sec. 31 Twp. 14 R. 13W

Well No. 3 Schnoor

Texas Company

Contractor

COMPLETED

NE NW SW


330 Ft. from N. Line

Ft. from S. Line

Ft. from E. Line

990 Ft. from W. Line

SECTION PLAT

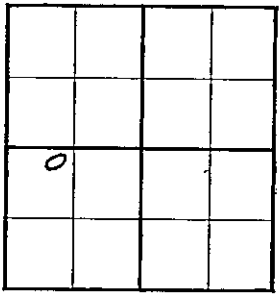

Location

Rig up

Drilling and Remarks:

Pot 370

RECORD

Cased 5 in., 3208 ft.

Sand Gorham 3211

Gas

Oil

Total Depth 3218

PRODUCTION

1st 24 hrs. Nat.

1st 24 hrs. after shot

Gas Cu. Ft.

Dry Hole

Abandoned

Date

APR 27 1938 19

H. D. Hatfield Scout