


Section 19 Township 29 Range 8E ✓Well No. 1 FagerbergCompany Rex & Morris & C R A

NORTH

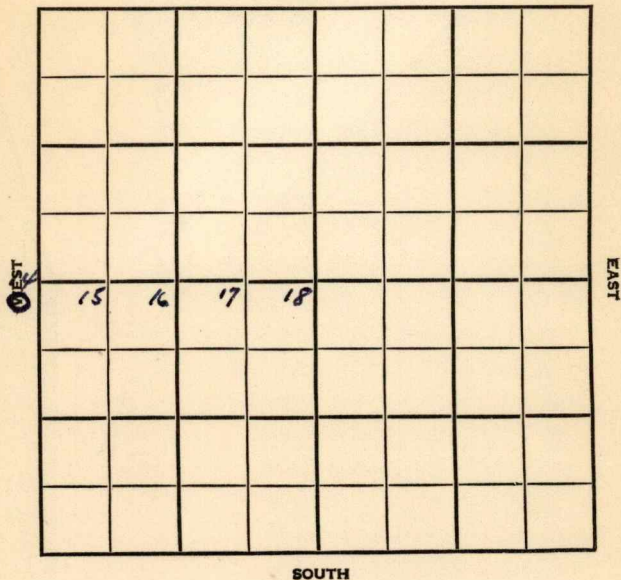

SOUTH

| SEC. | TWP. | R. |
|------|------|----|
| 19   | 29   | 8E |

WELL NO.

1 Fagerberg

FARM

COMPANY

Rex &amp; Morris &amp; CRA

CONTRACTOR

Rex &amp; Morris Tools

Wildcat


330 Ft. from N. Line

Ft. from S. Line

330 Ft. from E. Line

Ft. from W. Line

NE Cor Lot #14

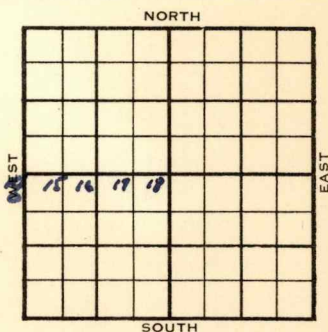

ELEVATION

REPORT

1954

9/22

C&amp;P

9/29

Spud 9-23-54 D & A TD 2825  
 Br. lime 1655 Stal. 6178 Lans 1782  
 B. Lans. 1824 KC 1972 B KC 2168  
 Ft. Scott 2410 Cherokee sh 2494  
 Cherty Cong. 2756 Miss 2765  
 TD 2825 D & A

ABANDONED

County Butler State Kansas  
 Sec. 19 (Blk. 29 (Sur. 8E Map No.  
 (Twp.) (Rge.)  
 Operator Rex & Morris & C.R.A.  
 Well No. 1 Farm Fagerberg  
 Elev. Location NE cor Lot #14



330 Ft. From N Line NE  
330 Ft. From E Line Quarter

1st. Report Sep 22 1954

Completion SEP 29 1954

Remarks

Rex & Morris Tools

Spudding Date 9-23-54

Drlg. Data D & A TD 2825 Wildcat  
Br. lime 1655 Stal. 1678 Lans. 1782  
B. Lans. 1824 KC 1972 B KC 2168  
Ft. Scott 2410 Cherokee sh. 2494  
Cherty Cong. 2756 Miss. 2765 TD 2825  
D & A

FABEN GILSTRAP

