

Butler


KANAS

SECTION 18 TOWNSHIP 29 RANGE 8E

WELL NO. #1 Fagerberg Properties

COMPANY Beaumont Petroleum

NORTH SE NE NE

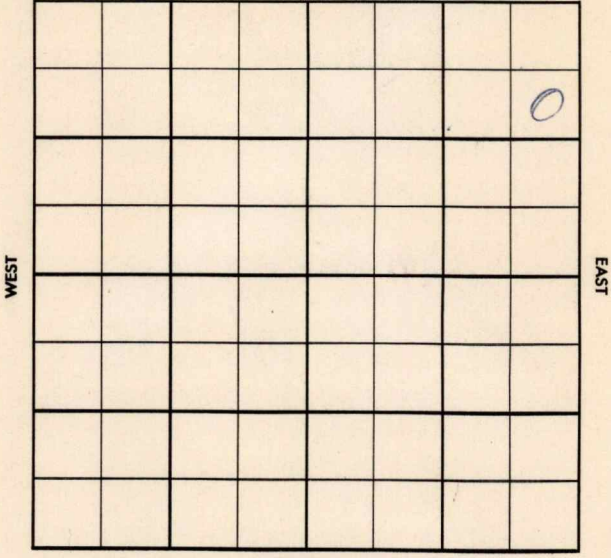

SOUTH

Co.

County Butler Elev. 1582 RB  
 Sec. 18 Twp. 29 Rgs. SE  
 Company Beaumont Petroleum  
 Farm Name Fagerberg Properties No. 1

| TOPS   | DEPTH        | LOG         | DATUM |
|--------|--------------|-------------|-------|
| Anh.   |              |             |       |
| Tp.    |              |             |       |
| H.     |              |             |       |
| Tr.    |              |             |       |
| Dg.    |              |             |       |
| Bl.    |              |             |       |
| L.     |              |             |       |
| K.C.   | <u>2014</u>  |             |       |
| B.K.C. | <u>2250</u>  |             |       |
| Ce.    |              |             |       |
| C.     | <u>Marm</u>  | <u>2253</u> |       |
| M.     | <u>ce</u>    | <u>2505</u> |       |
| M.     | <u>chert</u> | <u>2726</u> |       |
| K.     | <u>M. Li</u> | <u>2786</u> |       |
| Mz.    |              |             |       |
| Mq.    |              |             |       |
| V.     |              |             |       |
| S.     |              |             |       |
| A.     |              |             |       |
| R.     |              |             |       |
| PE.    |              |             |       |
| G.     |              |             |       |
| T.D.   | <u>2910</u>  |             |       |

Loc. in Sec. SE NE NE  
 Geol. \_\_\_\_\_  
 Contr. \_\_\_\_\_  
 Co. Tools \_\_\_\_\_  
 Pool \_\_\_\_\_  
 Shinn, NE

|           |  |  |
|-----------|--|--|
| AUG 7 '57 |  |  |
| ABANDONED |  |  |

Use.

No.

Sec.

T.

R.

Date Comm. \_\_\_\_\_  
 Location JUL 3 '57 6-25-57 85/8  
35 R29 5 1/2 JUL 10 '57 5 1/2 2910  
JUL 17 '57 JUL 24 '57 12/2827-31 18/  
2837-40 Frac Hole Full wt  
50g. JUL 31 '57 RePF 14/2851-54  
AUG 8 '57 143/2823-79 no oil  
or wt

D & A

County Butler Elev. \_\_\_\_\_  
 Sec. 18 Twp. 29 Rge. SE  
 Company Beaumont Petroleum  
 Farm Name Fagerberg Properties No. 1

| TOPS   | DEPTH | LOG | DATUM | Loc. in Sec. |
|--------|-------|-----|-------|--------------|
| Anh.   |       |     |       | SE NE NE     |
| TP.    |       |     |       |              |
| H.     |       |     |       |              |
| Tr.    |       |     |       |              |
| Dg.    |       |     |       |              |
| Bl.    |       |     |       |              |
| L.     |       |     |       | Geol. _____  |
| K.C.   |       |     |       | Contr _____  |
| B.K.C. |       |     |       |              |
| Ce.    |       |     |       | Co. Tools    |
| C.     |       |     |       |              |
| M.     |       |     |       | Pool         |
| M.     |       |     |       | Shinn, NE    |
| K.     |       |     |       |              |
| Mz.    |       |     |       |              |
| Ma.    |       |     |       |              |
| V.     |       |     |       |              |
| S.     |       |     |       |              |
| S.     |       |     |       |              |
| A.     |       |     |       | FIRST REPORT |
| R.     |       |     |       |              |
| PE.    |       |     |       |              |
| G.     |       |     |       |              |
| TD.    |       |     |       |              |

JUN 26 1957  
 FIRST REPORT

Date Comm. \_\_\_\_\_  
 Location \_\_\_\_\_

~~30~~

Co.  
Lse.  
No.  
Sec.  
T.  
R.