

| | | |
|------|------|------|
| SEC. | TWP. | R. |
| 18 | 29 | 8E ✓ |


WELL NO. #2 Hoard "5"

FARM

COMPANY
Beaumont Pet.

CONTRACTOR
Beaumont

_____ Ft. from N. Line
330 _____ Ft. from S. Line
990 _____ Ft. from E. Line
_____ Ft. from W. Line

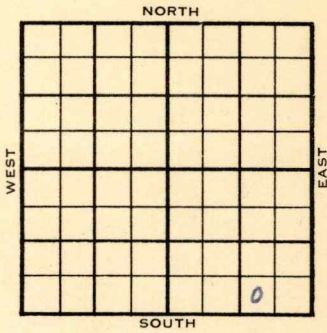

SW SE SE

| | | |
|------|------------------|--------|
| 1953 | ELEVATION --- | REPORT |
|------|------------------|--------|

10/7
11/18

Location
Spud 10-5-53
Oil well TD 2862 10" @ 45
KC 2010 B KC 2251 Miss 2802
TD 2862 5" @ 2862 CO to 2843
98/2826-40 1000 A
Comp. 7 BOPD 20 BW

COMPLETED


County Butler State Kansas

Sec. 18 (Blk. 29) (Sur. 8E) Map No.

Operator Beaumont Pet.

Well No. 2 Farm Hoard "B"

Elev. _____ Location SW SE SE

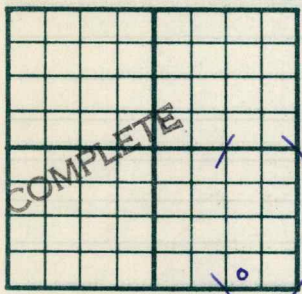

330 Ft. From S Line SE

990 Ft. From E Line Quarter

1st. Report

Completion NOV 18 1953

Remarks

Beaumont - Contr.

Spudding Date 10-5-53

Drlg. Data Oil well TD 2862

10" @ 45 KC 2010 B KC 2251

Miss. 2802 TD 2862 5" @ 2862

CO to 2843 98/ 2826-40 1000 A

Comp. 7 hoptd 20 bw

J. G. McGEHEE

Kansas

Map No. _____ Sec. 18 Twp. 29 R. 8E

Well No. 2 Hoard "B"

Beaumont Company

CORRECTION Contractor

SW SE SE

SECTION PLAT

_____ Ft. from N. Line

330 Ft. from S. Line

990 Ft. from E. Line

_____ Ft. from W. Line

| | | | |
|--|--|--|--|
| | | | |
| | | | |
| | | | |
| | | | |

Butler County

Location _____

Rig up _____

Drilling and Remarks:

Reported
#1 Hoard "C"

RECORD

Cased _____ in., _____ ft.

Sand _____

Gas _____

Oil _____

Total Depth _____

PRODUCTION

1st 24 hrs. Nat. _____

1st 24 hrs. after shot _____

Gas _____ Cu. Ft.

Dry Hole _____

Abandoned _____

Date

OCT 9 8 1953

19

J. G. McGEHEE

Scout

