

SOUTH

0							

EAST

WEST

Hall-Gurney

NORTH

Company V.D. Sley

Well No. 4 Wilson

Section 25 Township 14 Range 13W

Russell

KANONS

FORM 51 25M 3-49

Sec. 25

Twp. 14

R. 13M

Russell KANSAS

Well No. #4 Wilson Farm

V. D. Sibley

Company

Hall-Gurney Pool (Murfin, Cont. NORTH)

_____ Ft. from N. Line

330'


_____ Ft. from S. Line

330'

_____ Ft. from E. Line

_____ Ft. from W. Line

SE NE

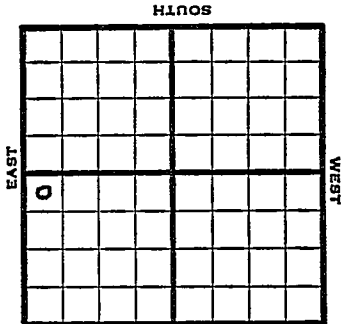

1949

REPORT Elev 1708'

8/31

10" @ 125'

9/7

Drig. 2150'

9/17

Drig. 2000'

9/21

"

9/28

"

10/5

"

10/12

"

10/19

"

10/26

"

11/1

"

11/7

"

11/16

"

11/23

"

11/30

FD 2900'

Transing 2878'
5" @ 2880'
Pump 50 041
70° Gr1
Comp

COMPLETED

Map No. _____ Sec. 25 Twp. 14 R. 13W

Well No. 4 Wilson

V. D. Sledge

Company _____

Wurtin

Contractor _____

SE NE

FIRST REPORT SECTION PLAT

_____ Ft. from N. Line

330

_____ Ft. from S. Line

330

_____ Ft. from E. Line

_____ Ft. from W. Line

Russell County

Location _____

Rig up _____

Drilling and Remarks:

10" @ 125

dris. 2150

RECORD

Cased _____ in, _____ ft.

Sand _____

Gas _____

Oil _____

Total Depth _____

PRODUCTION

1st 24 hrs. Nat. _____

1st 24 hrs. after shot _____

Gas _____ Cu. Ft. _____

Dry Hole _____

Abandoned _____

Date _____

AUG 31 1949

S. J. LEWIS

Scout

NOV 30 1949 19

S. J. LEWIS

Scout

Date

HO 28

Long cont.

*10m 28H
5' 28H*

Drilling and Remarks:

Rig up

Location

Russell County

ft. from W. Line

330 ft. from E. Line

330 ft. from S. Line

ft. from N. Line

SE NE

SECTION PLAT

E11708

Contractor

COMPLETE

Company

V. D. Slay

Well No. 4 WILSON

Map No. Sec. 25 Twp. 14 R. 13W

Kansas

Form 26 200 Bks. 6-49 Petrol

Ha11-Gurney Pool

PRODUCTION

1st 24 hrs. Nat.

1st 24 hrs. after shot

Gas Cu. Ft.

Dry Hole

Abandoned

RECORD

Cased in, ft.

Sand

Gas

Oil

Total Depth 2500