

KANSAS


Butler county

FORM 51 5M 6-46 PETROL

Section 19 Township ²⁹~~27-28~~ Range 8-E

Well No. #1, Shinn

Company K. T. Weidemann

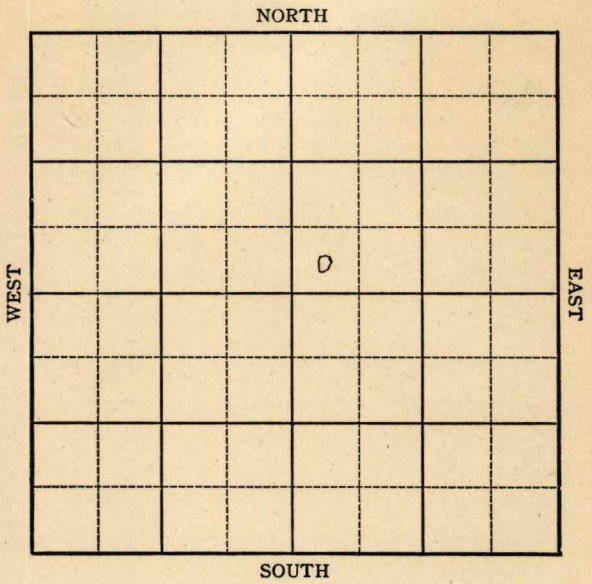


Sec. 19 Twp. ~~28~~ 27-29 R. 8E

Well No. #1 Shinn Farm
K. T. Weidemann Company

Miscellaneous

 Ft. from N. Line
330 Ft. from S. Line
 Ft. from E. Line
330 Ft. from W. Line

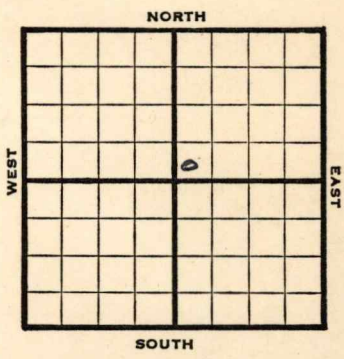

SW NE

REPORT

1946	
9/18	Location 9-16-46 Spud
9/24	Drlg 600'
10/1	12" @ 1126 Drlg 1225'
10/8	" "
10/22	8" @ 1780' CO
10/29	Drlg 2204'
11/6	Drlg 2350'
11/12	Drlg 2705'
11/20	" "
11/27	Miss 2730' 6" @ 2763' TD 2770'
12/3	"
12/11	Miss 2730' 6" @ 2763' TD 2773' 1000 Acid Pump 30 POT 36 Grav.

COMPLETED

Kansas Pool Name Miscellaneous
Map No. 10 Sec. 19 Twp. 28 R. 8E

Well No. 1 Shinn

K.T. Weidemann Company

FIRST REPORT Contractor

SW NE

SECTION PLAT

 Ft. from N. Line

330 Ft. from S. Line

 Ft. from E. Line

330 Ft. from W. Line

		o	

Butler County

Location 9/16

Rig up

Drilling and Remarks:

Spud.

RECORD

Cased in., ft.

Sand

Gas

Oil

Total Depth

PRODUCTION

1st 24 hrs. Nat.

1st 24 hrs. after shot

Gas Cu. Ft.

Dry Hole

Abandoned

Date

SEP 1 8 1946 19

S. J. LEWIS Scout

Kansas

Map No. _____ Sec. 19 Twp. 29 R. 8E

Well No. 1 Shinn

K. T. Weidemann Company

COMPLETED Contractor

SW NE

SECTION PLAT

_____ Ft. from N. Line

330 Ft. from S. Line

_____ Ft. from E. Line

330 Ft. from W. Line

Butler County

Location _____

Rig up _____

Drilling and Remarks:

Miss 2780
6" @ 2763
1000 acid
Pump 30 ft

36 @

RECORD

Cased _____ in., _____ ft.

Sand _____

Gas _____

Oil _____

Total Depth 2728

PRODUCTION

1st 24 hrs. Nat. _____

1st 24 hrs. after shot _____

Gas _____ Cu. Ft.

Dry Hole _____

Abandoned _____

Date

DEC 1 1 1946

19

S. J. LEWIS

Scout