

Butler


KANSAS

FORM 51 IOM 12-46 PETROL

Section 19 Township 29 Range 8E

Well No. 4 Shinn

Company K. T. Weidemann

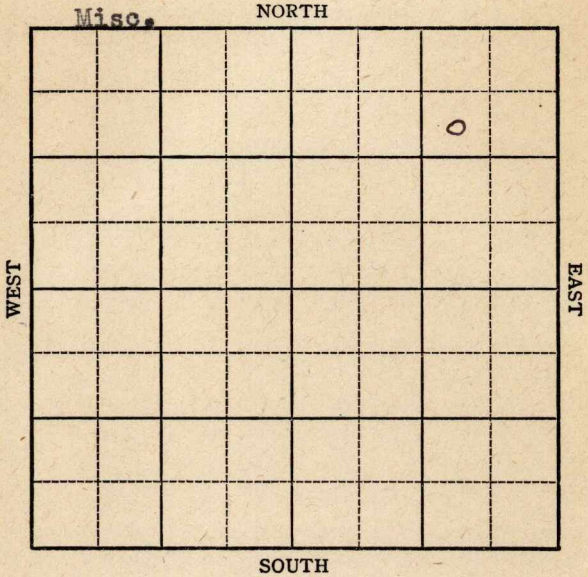

KANSAS

BUTLER  
Greenwood



Sec. 19 Twp. 29 R. 8E

Well No. #4 Shinn Farm

K. T. Weidemann Company


Misc.

990 Ft. from N. Line

\_\_\_\_\_ Ft. from S. Line

990 Ft. from E. Line

\_\_\_\_\_ Ft. from W. Line

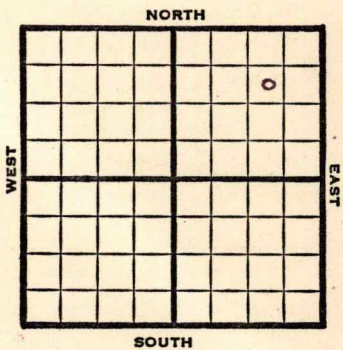

SW NE NE

REPORT

1947

7/23 RUR

7/29 Drlg 950'

8/6 10" @ 37'  
Kc 1990'  
Miss. 2746'  
TD 2770'

8/13 5" @ 2770  
RUST

8/20 "

8/27 "

9/3 Miss. 2746'  
5" @ 2770'  
500 Acid  
Pump 25 Pot  
38.0 Gr.  
TD 2780'

COMPLETED

Kansas

Map No. \_\_\_\_\_ Sec. 19 Twp. 29 R. 8E

Well No. 4 Shinn

K. T. Weidemann Company

FIRST REPORT Contractor

SW NE NE

SECTION PLAT

990 Ft. from N. Line

			o

\_\_\_\_\_ Ft. from S. Line

990 Ft. from E. Line

\_\_\_\_\_ Ft. from W. Line

BUTLER  
Greenwood County

Location \_\_\_\_\_

RECORD

Rig up \_\_\_\_\_

Cased \_\_\_\_\_ in., \_\_\_\_\_ ft.

Drilling and Remarks:

Sand \_\_\_\_\_

Gas \_\_\_\_\_

Oil \_\_\_\_\_

R U R

Total Depth \_\_\_\_\_

PRODUCTION

1st 24 hrs. Nat. \_\_\_\_\_

1st 24 hrs. after shot \_\_\_\_\_

Gas \_\_\_\_\_ Cu. Ft.

Dry Hole \_\_\_\_\_

Abandoned \_\_\_\_\_

Date

JUL 23 1947

S. J. LEWIS

19

Scout

Map No. 10 Sec. 19 Twp. 29 R. 8E

Well No. 4 Shinn

K. T. Weidemann Company

CORRECTION Contractor

SW NE NE

SECTION PLAT

			6

990 Ft. from N. Line

\_\_\_\_\_ Ft. from S. Line

990 Ft. from E. Line

\_\_\_\_\_ Ft. from W. Line

Butler County

Location \_\_\_\_\_

Rig up \_\_\_\_\_

Drilling and Remarks:

Reported in

Greenwood County

RECORD

Cased \_\_\_\_\_ in., \_\_\_\_\_ ft.

Sand \_\_\_\_\_

Gas \_\_\_\_\_

Oil \_\_\_\_\_

Total Depth \_\_\_\_\_

PRODUCTION

1st 24 hrs. Nat. \_\_\_\_\_

1st 24 hrs. after shot \_\_\_\_\_

Gas \_\_\_\_\_ Cu. Ft.

Dry Hole \_\_\_\_\_

Abandoned \_\_\_\_\_

Date

JUL 30 1947

19

S. J. LEWIS

Scout

Map No. 10 Sec. 19 Twp. 29 R. 8E

Well No. 4 Shinn

K. T. Weidemann Company

COMPLETE Contractor

SW NE NE

SECTION PLAT

999 Ft. from N. Line

\_\_\_\_\_ Ft. from S. Line

990 Ft. from E. Line

\_\_\_\_\_ Ft. from W. Line

			o

*Butter*

Location \_\_\_\_\_

Rig up \_\_\_\_\_

Drilling and Remarks:

*Miss 2746*  
*5" @ 2770*  
*500 acid*  
*Pump 25 RT*  
*38" SW*

RECORD

Cased \_\_\_\_\_ in., \_\_\_\_\_ ft.

Sand \_\_\_\_\_

Gas \_\_\_\_\_

Oil \_\_\_\_\_

Total Depth 2780

PRODUCTION

1st 24 hrs. Nat. \_\_\_\_\_

1st 24 hrs. after shot \_\_\_\_\_

Gas \_\_\_\_\_ Cu. Ft.

Dry Hole \_\_\_\_\_

Abandoned \_\_\_\_\_

Date

SEP 3 1947 19

S. I. LEWIS Scout