

Section 32 Township 14 Range 13WWell No. #1 RoggCompany Keystone Pet.

NORTH

							0

WEST

EAST

SOUTH

NOT FILE Russell

KANSAS

Sec. 32 Twp. 14 R. 13W

Well No. #1 Rogg Farm

Keystone Pet. Company

MPC Reserves 1/16 of 7/8 Oil-Gas etc Contractor

Hall-Gurney Pool


660' Ft. from N. Line

Ft. from S. Line

330' Ft. from E. Line

Ft. from W. Line

C E L NE NE

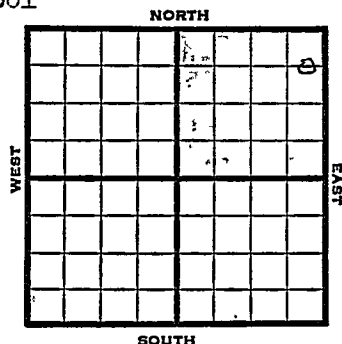

1951

Elev. -

REPORT

6/6


Location

Cable Tool Test
Arbuckle Test Apprx
3150'

6/13

Abandoned Location

ABANDONED

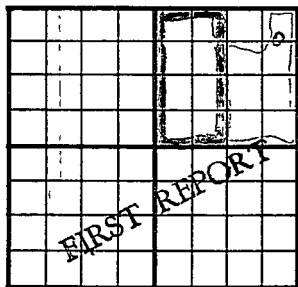County Russell State KansasSec. 32 (Blk. Twp.) 14 (Sur. Rge.) 13W Map No.Operator Keystone Pet.Well No. 1 Farm RoggElev. Location C E I. NE NE660 Ft. From N Line NE330 Ft. From E Line Quarter1st. Report JUN 6 1951

Completion

Remarks


Spudding Date

Drig. Data Hall-Gurney Pool

Location

J. E. TYRA

County Russell State Kansas
 Sec. 32 (Blk. Twp.) 14 (Sur. Rge.) 13W Map No.
 Operator Keystone Pet.
 Well No. 1 Farm Rogg
 Elev. _____ Location C E L NE NE

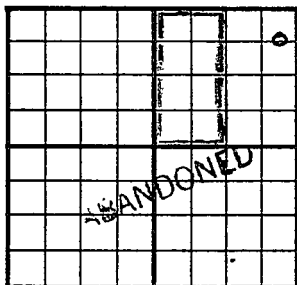

660 Ft. From N Line NE
330 Ft. From E Line Quarter

1st. Report

Completion JUN 13 1951

Remarks Hall-Gurmey Pool

Spudding Date

Drilg. Data

Abd. location